

Marshall
E 200
9-25-75

MISSISSIPPI
 BOARD OF WATER COMMISSIONERS
 416 North State Street
 Jackson, Mississippi 39201

WATER WELL DRILLERS LOG

Sept 25 1975 Earl Jones Well Co - Marshall
 date well completed firm name county well located

LANDOWNER:
Charles D. Polk.
Byhalia Miss. RT
 (mailing address)

description of formations encountered	from	to
<u>Top soil & clay</u>	<u>0</u>	<u>16</u>
<u>sand</u>	<u>16</u>	<u>40</u>
<u>clay</u>	<u>40</u>	<u>50</u>
<u>sand -</u>	<u>50</u>	<u>108</u>

WELL LOCATION:
 sec. 20 T. 2 N R. 4 E 15E
 S W
3 1/2 miles N of Victor
 (distance) (direction) (nearest town)

WELL PURPOSE: Home
 (home, irrigation, municipal, industrial)

WELL COMPLETION DATA:

(1) diameter (inches) 4"

(2) total depth (feet) 108

(3) static water level (feet) 58 below above top of ground.

(4) casing plastic 98
 (material) (depth)
4" if telescope see back.
 (size)

(5) screen 10' 98
 (length) (depth to top)
0.13 plastic
 (size) (material)

(6) pump 1/2 16
 (HP) (yield gpm)
Electric
 (type power)

(7) electric log no
 (yes or no)

(organization running log)


(8) how well bottom plugged plastic cap

DRILLERS REMARKS:

MISSISSIPPI BOARD OF WATER COMMISSIONERS
 OCT 28 1975
 MISS. Bd. of WATER COMMISSIONERS

If well telescopes please sketch and show depths.

GROUND LEVEL

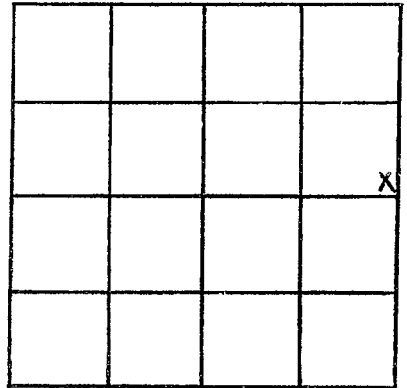

SECTION 20

Please indicate well location X.

ADDITIONAL INFORMATION

If more than one screen, show locations of each on sketch.