

Marshall  
E 2001  
9-27-75

MISSISSIPPI  
 BOARD OF WATER COMMISSIONERS  
 416 North State Street  
 Jackson, Mississippi 39201

WATER WELL DRILLERS LOG

156 9-27 1975 W.A. Mason Water Well Contractor Marshall  
 date well completed firm name county well located


| LANDOWNER: <u>V. Schaak</u><br><u>Rt. 1</u>  | description of formations encountered | from      | to         |
|--|---------------------------------------|-----------|------------|
| <u>Byhalia Miss.</u><br>(mailing address)  | <u>clay silt</u>                      | <u>10</u> | <u>8</u>   |
| WELL LOCATION:<br>sec. <u>30</u> T. <u>2</u> N. R. <u>4</u> E<br><u>2</u> miles <u>NE</u> of <u>Byhalia</u><br>(distance) (direction) (nearest town) | <u>Red sand</u>                       | <u>8</u>  | <u>30</u>  |
| WELL PURPOSE: <u>Home</u><br>(home, irrigation, municipal, industrial)   | <u>White sand</u>                     | <u>30</u> | <u>130</u> |
| WELL COMPLETION DATA:  |                                       |           |            |
| (1) diameter (inches) <u>4</u>   |                                       |           |            |
| (2) total depth (feet) <u>130'</u>   |                                       |           |            |
| (3) static water level (feet) <u>58</u> below top of ground.   |                                       |           |            |
| (4) casing <u>Plaster</u> , <u>120'</u><br>(material) (depth)<br><u>4"</u><br>(size) if telescope see back.  |                                       |           |            |
| (5) screen <u>10'</u> , <u>120'</u><br>(length) (depth to top)<br><u>4"</u> , <u>Plaster</u><br>(size) (material)                                    |                                       |           |            |
| (6) pump <u>3/4</u> , <u>15</u><br>(HP) (yield gpm)<br><u>electric</u><br>(type power)   |                                       |           |            |
| (7) electric log <u>No</u><br>(yes or no)  |                                       |           |            |
| (organization running log)   |                                       |           |            |
| (8) how well bottom plugged<br><u>Cap on screen</u>  |                                       |           |            |
| DRILLERS REMARKS:  |                                       |           |            |

RECEIVED  
 FEB 17 1976

MISSISSIPPI WATER COMMISSION

If well telescopes please sketch and show depths.

GROUND LEVEL

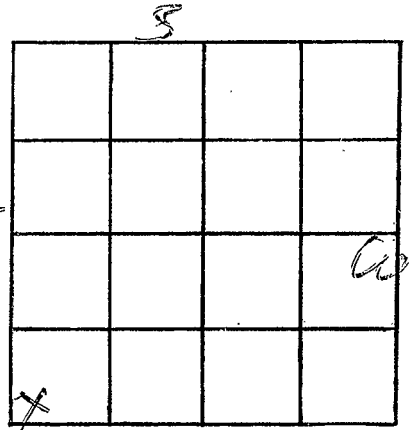

SECTION 30

Please indicate well location X.

ADDITIONAL INFORMATION

If more than one screen,  
show locations of each on sketch.