

MISSISSIPPI  
 BOARD OF WATER COMMISSIONERS  
 416 North State Street  
 Jackson, Mississippi 39201

WATER WELL DRILLERS LOG

Marshall  
 E 202  
 10-2-75

Oct. 2 1975 Earl Jones Well Co. Marshall  
 date well completed firm name county well located

LANDOWNER:  
 P. L. Dowdy  
 Byhalia miss. RT.  
 (mailing address)  
 WELL LOCATION:  
 sec. 22 T. 2 N. R. 4 E 15E  
 S. W. Victoria  
 3 1/4 miles N. (distance) (direction) (nearest town)

description of formations encountered	from	to
Topsoil & clay	0	18
sand	18	50
clay	50	62
sand	62	110

WELL PURPOSE: Home  
 (home, irrigation, municipal, industrial)

- WELL COMPLETION DATA:
- (1) diameter (inches): 4"
  - (2) total depth (feet): 110
  - (3) static water level (feet): 65 below top of ground.
  - (4) casing: plastic (material), 100 (depth)  
 4" (size) if telescope see back.
  - (5) screen: 10' (length), 100' (depth to top)  
 4" (size), plastic (material)
  - (6) pump: 1/2 (HP), 16 (yield gpm)  
 electric (type power)
  - (7) electric log: no (yes or no)


(organization running log)  
 (8) how well bottom plugged: plastic cap

DRILLERS REMARKS:

OCT 28 1975

If well telescopes please sketch and show depths.

GROUND LEVEL

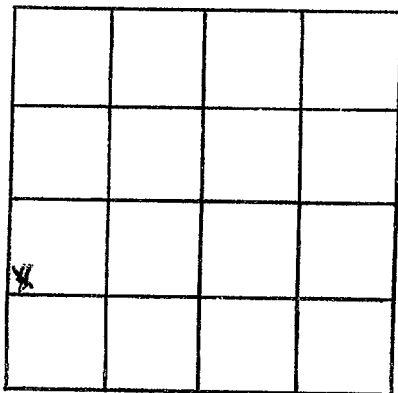

SECTION 22

Please indicate well location X.

ADDITIONAL INFORMATION

If more than one screen,  
show locations of each on sketch.