

Marshall
E 203
10-23-75

MISSISSIPPI
BOARD OF WATER COMMISSIONERS
416 North State Street
Jackson, Mississippi 39201

WATER WELL DRILLERS LOG

10-23
date well completed

1975 Demsted Surfaced
firm name

Northall
county well located

LANDOWNER:

Jones, Howard
Coyce, Miss.
(mailing address)

description of formations
encountered

from to

WELL LOCATION:

sec. 3 T. 2 N. R. 14 E.
4 miles East of Coyce
(distance) (direction) (nearest town)

WELL PURPOSE: (home, irrigation, municipal, industrial)

WELL COMPLETION DATA:

- (1) diameter (inches) 4"
- (2) total depth (feet) 207 feet
- (3) static water level (feet) 110 below above top of ground.
- (4) casing PVC, 207, (material) (depth)
(size) if telescope see back.
- (5) screen 2 ft., 200 feet (length) (depth to top)
4" gravel wall (size) (material)
- (6) pump 3/4 HP, 14 (HP) (yield gpm)
(type power)
- (7) electric log Yes (yes or no)
- (8) how well bottom plugged 1/2 cap.


clay	0	105
sand	105	110
clay	110	120
Rock	120	122
clay	122	175
sand	175	207

DRILLERS REMARKS:

NOV 6 1975

If well telescopes please sketch and show depths.

GROUND LEVEL

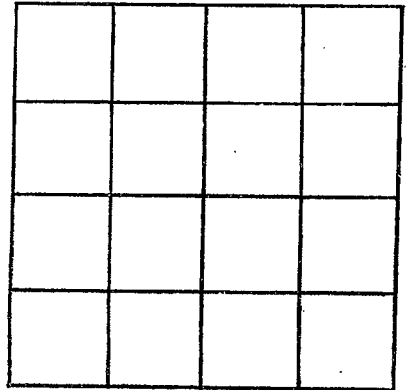

SECTION _____

Please indicate well location X.

ADDITIONAL INFORMATION

If more than one screen,
show locations of each on sketch.