

Marshall
E 2005
6-3-76

MISSISSIPPI
BOARD OF WATER COMMISSIONERS
416 North State Street
Jackson, Mississippi 39201

15E

WATER WELL DRILLERS LOG

June 3, 1976 Earl Jones Well Co Marshall
date well completed firm name county well located

LANDOWNER:
Mamie Odum
Colleville Tenn. Rt.
(mailing address)

WELL LOCATION:
sec. W T 2 N R 4 E
3 miles S-E of Coyce
(distance) (direction) (nearest town)

WELL PURPOSE: Home
(home, irrigation, municipal, industrial)

WELL COMPLETION DATA:

- (1) diameter (inches) 2"
- (2) total depth (feet) 100
- (3) static water level (feet) 60 below above top of ground.
- (4) casing plastic 100
(material) (depth)
2"
(size) if telescope see back.
- (5) screen 10' 100
(length) (depth to top)
0/3-2" plastic
(size) (material)
- (6) pump 1 5
(HP) (yield gpm)
electric
(type power)
- (7) electric log no
(yes or no)
- (organization running log)
- (8) how well bottom plugged plastic cap

description of formations encountered	from	to
Topsoil	0	12
sand	12	18
clay	18	30
sand	30	40
clay	40	62
sand	62	110


RECEIVED
JUL - 7 1976

DRILLERS REMARKS:

MISS. Bd. OF WATER COMMISSIONERS

If well telescopes please sketch and show depths.

GROUND LEVEL

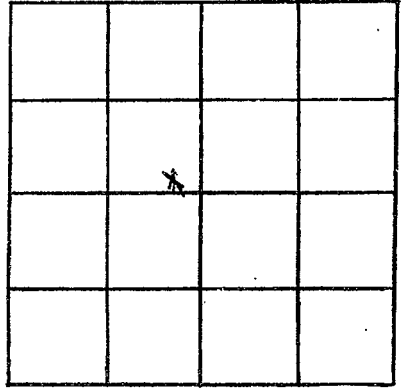

SECTION 11

Please indicate well location X.

ADDITIONAL INFORMATION

If more than one screen,
show locations of each on sketch.