

Marshall
E 2007
6-10-76

MISSISSIPPI
 BOARD OF WATER COMMISSIONERS
 416 North State Street
 Jackson, Mississippi 39201

WATER WELL DRILLERS LOG

June 10 1976 Evel Jones Well Co Marshall
 date well completed firm name county well located

LANDOWNER:
J.P. Woods
Byhalis Miss.
 (mailing address)

WELL LOCATION:
 sec 32 T 2 N R 4 E
2 miles E. of Byhalis
 (distance) (direction) (nearest town)

WELL PURPOSE: Domestic
 (home, irrigation, municipal, industrial)

- WELL COMPLETION DATA:
- (1) diameter (inches) 4"
 - (2) total depth (feet) 154
 - (3) static water level (feet) 90 below/above top of ground.
 - (4) casing plastic 144
 (material) (depth)
4" if telescope see back.
 (size)
 - (5) screen 10' 144
 (length) (depth to top)
4" 0.013 plastic
 (size) (material)
 - (6) pump 1 30
 (HP) (yield gpm)
Electric
 (type power)
 - (7) electric log no
 (yes or no)

(organization running log)

(8) how well bottom plugged plastic casing

DRILLERS REMARKS:


description of formations encountered	from	to
<u>Topsoil & clay</u>	<u>0</u>	<u>2</u>
<u>sand</u>	<u>2.2</u>	<u>48</u>
<u>clay</u>	<u>48</u>	<u>55</u>
<u>sand</u>	<u>55</u>	<u>82</u>
<u>clay</u>	<u>82</u>	<u>90</u>
<u>sand</u>	<u>90</u>	<u>154</u>

RECEIVED
JUL - 7 1976

MISS. BD. OF WATER COMMISSIONERS

If well telescopes please sketch and show depths.

GROUND LEVEL

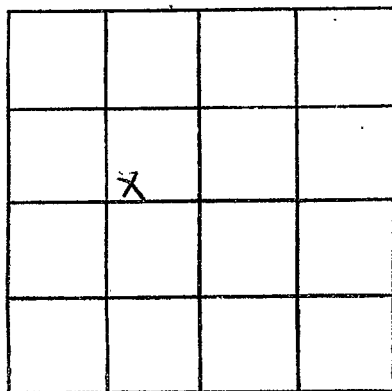

SECTION 32

Please indicate well location X.

ADDITIONAL INFORMATION

If more than one screen,
show locations of each on sketch.