

MARSHALL
E 7008
8-26-76

MISSISSIPPI
BOARD OF WATER COMMISSIONERS
416 North State Street
Jackson, Mississippi 39201

WATER WELL DRILLERS LOG

8-26-76 1976 date well completed
Bob Smith Well Serv firm name
Marshall county well located

LANDOWNER:
Earl Taylor
Byhalia, Miss.
(mailing address)

| description of formations encountered | from | to |
|---------------------------------------|------|-----|
| top soil | 0 | 5 |
| red clay | 5 | 40 |
| sand + clay | 40 | 100 |
| sand | 100 | 150 |

WELL LOCATION:
sec. 8 T. 10 N. R. 4 E
1 miles NE of Byhalia
(distance) (direction) (nearest town)

WELL PURPOSE:
(home, irrigation, municipal, industrial)

WELL COMPLETION DATA:

(1) diameter (inches) 4"

(2) total depth (feet) 150

(3) static water level (feet) 100 below top of ground.

(4) casing (material) plastic (depth) 150
(size) If telescope see back.

(5) screen (length) 10 (depth to top) 140
(size) 4 (material) plastic

(6) pump (HP) 1/2 (yield gpm) 10
(type power) E lu

(7) electric log (yes or no) no
(organization running log)

(8) how well bottom plugged


RECEIVED
SEP 20 1976

DRILLERS REMARKS:

MISS. Bd. OF WATER COMMISSIONERS

If well telescopes please sketch and show depths.

GROUND LEVEL

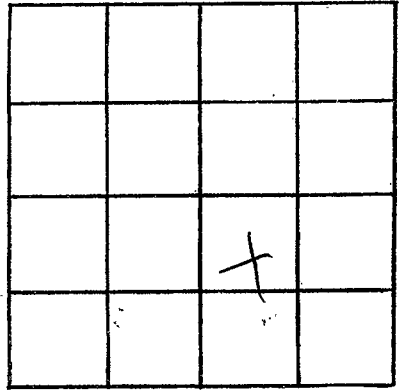

SECTION _____

Please indicate well location X.

ADDITIONAL INFORMATION

If more than one screen,
show locations of each on sketch.