

Marshall
E 2009
9-8-76

MISSISSIPPI
BOARD OF WATER COMMISSIONERS
416 North State Street
15E Jackson, Mississippi 39201

WATER WELL DRILLERS LOG

Sept 8

19 76 Earl Jones Well Co.

Marshall

date well completed

firm name

county well located

LANDOWNER:

Richard Brooks

Byhalia Miss. RT
(mailing address)

WELL LOCATION:

sec. 26 T-2 N R-4 E
3 miles N of Victoria
(distance) (direction) (nearest town)

WELL PURPOSE: Home
(home, irrigation, municipal, industrial)

WELL COMPLETION DATA:

- (1) diameter (inches) 4"
- (2) total depth (feet) 142'
- (3) static water level (feet) 98' below top of ground.
- (4) casing plastic 132' (material) (depth)
4' (size) If telescope see back.
- (5) screen 10' 132' (length) (depth to top)
4" o/d plastic (size) (material)
- (6) pump 1/2 HP 15 (yield gpm)
Electric (type power)
- (7) electric log no (yes or no)

(organization running log)

(8) how well bottom plugged
plastic cap.

description of formations encountered

from

to

Topsoil & clay	0	11
sand	11	18
clay	18	25
sand	25	78
clay	78	84
sand	84	140
clay	110	125
sand	125	142


RECEIVED
OCT 12 1976

MISS. BU. OF WATER COMMISSIONERS

DRILLERS REMARKS:

If well telescopes please sketch and show depths.

GROUND LEVEL

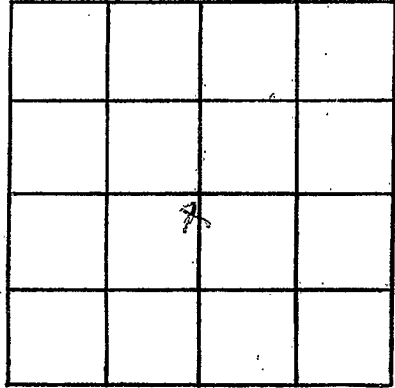

SECTION 26

Please indicate well location X.

ADDITIONAL INFORMATION

If more than one screen, show locations of each on sketch.