

MARSHALL
E 2011
12-10-76

MISSISSIPPI
 BOARD OF WATER COMMISSIONERS
 416 North State Street
 Jackson, Mississippi 39201

WATER WELL DRILLERS LOG

12-10-1976 W.A. Mason Marshall
 date well completed firm name county well located

LANDOWNER:
Morse Rose
Memphis Tenn
 (mailing address)

description of formations encountered	from	to
<u>Clay with</u>	<u>70</u>	<u>8</u>
<u>red clay</u>	<u>8</u>	<u>20</u>
<u>white clay</u>	<u>20</u>	<u>60</u>
<u>white sand</u>	<u>60</u>	<u>147</u>

WELL LOCATION:
 sec 21 T 2 N R 4 E
S W
3 1/4 miles NW of Victoria
 (distance) (direction) (nearest town)

WELL PURPOSE: private
 (home, irrigation, municipal, industrial)

- WELL COMPLETION DATA:
- (1) diameter (inches) 4"
 - (2) total depth (feet) 147'
 - (3) static water level (feet) 100 below top of ground.
 - (4) casing Plastic 127'
 (material) (depth)
4"
 (size) if telescope see back.
 - (5) screen 10' 127'
 (length) (depth to top)
4" Plastic
 (size) (material)
 - (6) pump 3/4 10
 (HP) (yield gpm)
electric
 (type power)
 - (7) electric log NO
 (yes or no)
 - (organization running log)
 - (8) how well bottom plugged Cap

RECEIVED


JUL 7 - 1977

DRILLERS REMARKS:

MISS. Bd. OF WATER COMMISSIONERS

If well telescopes please sketch and show depths.

GROUND LEVEL

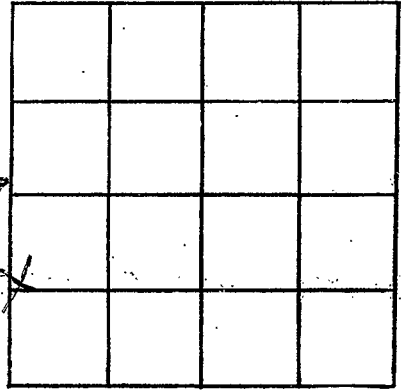

SECTION 21

Please indicate well location X.

ADDITIONAL INFORMATION

If more than one screen, show locations of each on sketch.