

Marshall
E 2012
12/10/76

MISSISSIPPI
 BOARD OF WATER COMMISSIONERS
 416 North State Street
 Jackson, Mississippi 39201

WATER WELL DRILLERS LOG

Dec 10 ¹⁹⁷⁶ Earl Jones Well Co Marshall
 date well completed firm name county well located

LANDOWNER:
N. A. Williams
Byhalia Miss. RT
 (mailing address)
 WELL LOCATION:
 sec 28 T 2 N R 4 E
 S W
3 miles N.W. of Victoria
 (distance) (direction) (nearest town)

description of formations encountered	depth	
	from	to
<u>topsoil & clay</u>	<u>0</u>	<u>14</u>
<u>sand</u>	<u>14</u>	<u>18</u>
<u>clay</u>	<u>18</u>	<u>45</u>
<u>sand</u>	<u>45</u>	<u>62</u>
<u>clay</u>	<u>62</u>	<u>65</u>
<u>sand</u>	<u>65</u>	<u>99</u>

WELL PURPOSE: Home
 (home, irrigation, municipal, industrial)

WELL COMPLETION DATA:
 (1) diameter (inches) 4"
 (2) total depth (feet) 99
 (3) static water level (feet) 80 below above top of ground.
 (4) casing plastic 99
 (material) (depth)
4" If telescope see back.
 (size)
 (5) screen 10' 99
 (length) (depth to top)
013-4" plastic
 (size) (material)
 (6) pump 1/2 15
 (HP) (yield gpm)
electric
 (type power)
 (7) electric log no
 (yes or no)
 (organization running log)


(8) how well bottom plugged
plastic cap
 DRILLERS REMARKS:

RECEIVED
 DEC 21 1976

MISSISSIPPI BOARD OF WATER COMMISSIONERS

If well telescopes please sketch and show depths.

GROUND LEVEL

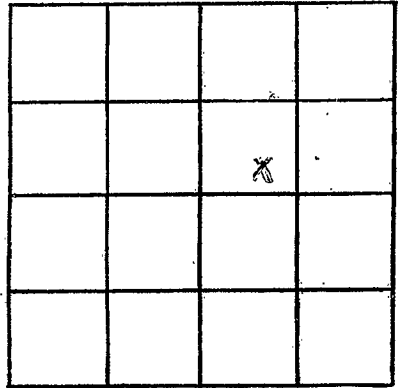

SECTION 28

Please indicate well location X.

ADDITIONAL INFORMATION

If more than one screen, show locations of each on sketch.