

MARSHALL
 E 2013
 2/24/77

MISSISSIPPI
 BOARD OF WATER COMMISSIONERS
 416 North State Street
 Jackson, Mississippi 39201

WATER WELL DRILLERS LOG

Feb 24 1977 date well completed
 Earl Jones Well Co. firm name
 Marshall county well located

LANDOWNER:
 E. H. Gorman
 Collierville Tn. RT 1
 (mailing address)
 WELL LOCATION:
 sec. 16 T 2 N R 4 S
 3 miles S of Cayce
 (distance) (direction) (nearest town)

description of formations encountered	from	to
	Topsoil & clay	0
Sand	8	18
Clay	18	30
Sand	30	70
Clay	70	78
Sand	78	100

WELL PURPOSE: Home
 (home, irrigation, municipal, industrial)

WELL COMPLETION DATA:
 (1) diameter (inches) 4"
 (2) total depth (feet) 100
 (3) static water level (feet) 56 below top of ground.
 (4) casing of plastic (material) 90 (depth)
 4 (size) if telescope see back.
 (5) screen 10' (length) 90 (depth to top)
 0.13-4" (size) plastic (material)
 (6) pump 1/2 (HP) 18 (yield gpm)
 Electric (type power)
 (7) electric log no (yes or no)
 (organization running log)

(8) how well bottom plugged
 plastic cap


DRILLERS REMARKS:

RECEIVED
 MAR 22 1977

MISS. Bd. OF WATER COMMISSIONERS

If well telescopes please sketch and show depths.

GROUND LEVEL

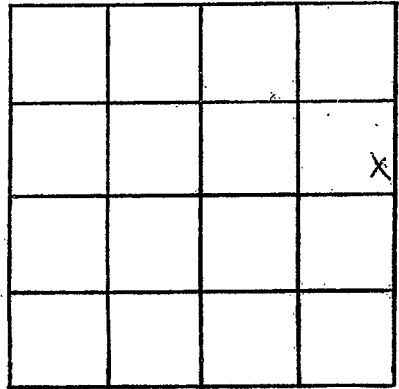

SECTION 3

Please indicate well location X.

ADDITIONAL INFORMATION

If more than one screen, show locations of each on sketch.