

MARSHALL
E 2014
6-11-77

MISSISSIPPI
 BOARD OF WATER COMMISSIONERS
 416 North State Street
 15E Jackson, Mississippi 39201

WATER WELL DRILLERS LOG

June 11 1977 Earl Jones Well Co. Marshall
 date well completed firm name county well located

LANDOWNER:
John H. Malone
Byhalia miss RT -
 (mailing address)
 WELL LOCATION:
 sec 27 T. 2 N. R. 4 E
2 1/2 miles N. of Victoria
 (distance) (direction) (nearest town)

description of formations encountered	from	to
<u>Topsoil + clay</u>	<u>0</u>	<u>10</u>
<u>sand</u>	<u>10</u>	<u>16</u>
<u>clay</u>	<u>16</u>	<u>25</u>
<u>sand</u>	<u>25</u>	<u>50</u>
<u>clay</u>	<u>50</u>	<u>55</u>
<u>sand</u>	<u>55</u>	<u>80</u>
<u>clay</u>	<u>80</u>	<u>88</u>
<u>sand</u>	<u>88</u>	<u>142</u>

WELL PURPOSE: Home
 (home, irrigation, municipal, industrial)


- WELL COMPLETION DATA:
- (1) diameter (inches) 4"
 - (2) total depth (feet) 142
 - (3) static water level (feet) 88 below top of ground.
 - (4) casing plastic 132
 (material) (depth)
4" If telescope see back.
 (size)
 - (5) screen 10' 132
 (length) (depth to top)
013- 4" plastic
 (size) (material)
 - (6) pump 1/2 16
 (HP) (yield gpm)
Electric
 (type power)
 - (7) electric log no
 (yes or no)
 - (organization running log)
 - (8) how well bottom plugged plastic caps

DRILLERS REMARKS:

RECEIVED
 JUL 5 1977
 MISS. BO. OF WATER COMMISSIONERS

If well telescopes please sketch and show depths.

GROUND LEVEL

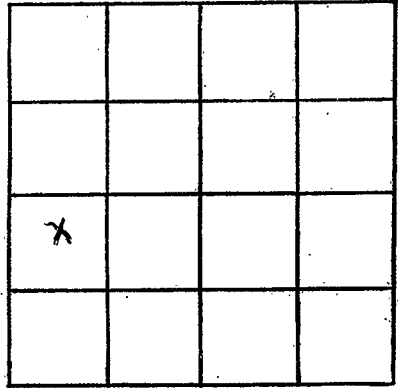

SECTION 27

Please indicate well location X.

ADDITIONAL INFORMATION

If more than one screen,
show locations of each on sketch.