

MARSHALL

E 2015

7-21-77

MISSISSIPPI BOARD OF WATER COMMISSIONERS
416 North State Street
Jackson, Mississippi 39201

15E

WATER WELL DRILLERS LOG

7-21 1977 date well completed

77 Dean Street Sub well firm name

Marshall county well located

LANDOWNER:

Paul Melton
Victoria, Miss.
(mailing address)

description of formations encountered

clay

from 0 to 50

Sand

50 160

WELL LOCATION:

sec. 22 2 N R 4 E
3 miles North of Victoria
(distance) (direction) (nearest town)

WELL PURPOSE: Drilling
(home, irrigation, municipal, industrial)

WELL COMPLETION DATA:

- (1) diameter (inches) 4"
- (2) total depth (feet) 160 feet
- (3) static water level (feet) 126 below top of ground.
- (4) casing PVC, 160 feet (material) (depth)

(size) If telescope see back.

- (5) screen 24", 153 feet (length) (depth to top)
- 4" gravel wall (size) (material)

- (6) pump 3/4 (HP) 14 (yield gpm)

(type power)

- (7) electric log Elect. (yes or no)

(organization running log)

- (8) how well bottom plugged 4" cap


DRILLERS REMARKS:

RECEIVED
AUG 17 1977

MISS. BD OF WATER COMMISSIONERS

If well telescopes, please sketch and show depths.

GROUND LEVEL

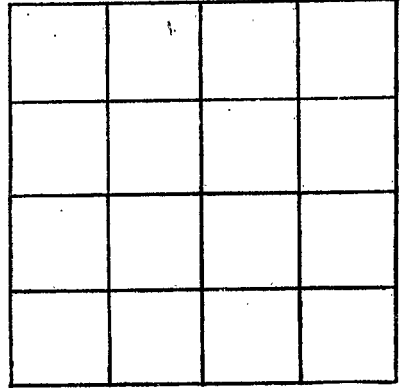

SECTION _____

Please indicate well location X.

ADDITIONAL INFORMATION

If more than one screen,
show locations of each on sketch.