

MARSHALL
E 2016
9-1-77

MISSISSIPPI
 BOARD OF WATER COMMISSIONERS
 416 North State Street
 15E Jackson, Mississippi 39201

WATER WELL DRILLERS LOG

Sept 1 1977 Earl Jones Well Co Marshall
 date well completed firm name county well located

LANDOWNER: Eddie Malone

description of formations encountered

from to

Byhalia Miss. RT 1
 (mailing address)

<u>Topsoil</u>	<u>0</u>	<u>6</u>
<u>sand</u>	<u>6</u>	<u>45</u>
<u>clay</u>	<u>45</u>	<u>48</u>
<u>sand</u>	<u>48</u>	<u>69</u>
<u>clay</u>	<u>69</u>	<u>74</u>
<u>sand</u>	<u>74</u>	<u>82</u>
<u>clay</u>	<u>82</u>	<u>98</u>
<u>sand</u>	<u>98</u>	<u>121</u>

WELL LOCATION:

sec 28 T 2 N R 4 E
 S W
2 miles N of Victoria
 (distance) (direction) (nearest town)

WELL PURPOSE: Home
 (home, irrigation, municipal, industrial)

WELL COMPLETION DATA:

- (1) diameter (inches) 4"
- (2) total depth (feet) 121
- (3) static water level (feet) 80 below above top of ground.

(4) casing Plastic 1 1/2"
 (material) (depth)
4" If telescope see back.
 (size)

(5) screen 10' 1 1/2"
 (length) (depth to top)

4" o.d. Plastic
 (size) (material)

(6) pump 1/2 1.6
 (HP) (yield gpm)

Electric
 (type power)

(7) electric log no
 (yes or no)

(organization running log)

(8) how well bottom plugged Plastic cap

DRILLERS REMARKS:

RECEIVED

SEP 10 1977


MISSISSIPPI BOARD OF WATER COMMISSIONERS

SEP 10 1977

MISSISSIPPI WATER COMMISSION

If well telescopes please sketch and show depths.

GROUND LEVEL

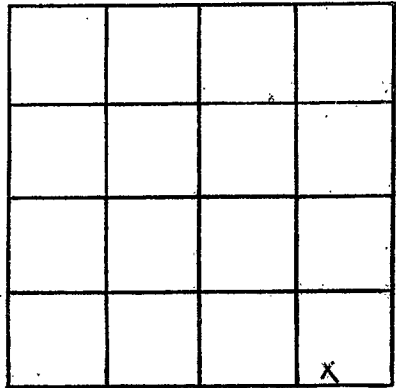

SECTION 28

Please indicate well location X.

ADDITIONAL INFORMATION

If more than one screen, show locations of each on sketch.