

Marshall
E 2017
9-3-77

MISSISSIPPI
BOARD OF WATER COMMISSIONERS
416 North State Street
15E Jackson, Mississippi 39201

WATER WELL DRILLERS LOG

Sept 3 1977 date well completed
Earl Jones Well Co. firm name
Marshall county well located

LANDOWNER:
Felix Moore Jr.
Red Banks Miss v RT1
(mailing address)

WELL LOCATION:
sec. 25 T 2 N R 4 E
3 3/4 1/2 S NE W
miles (distance) (direction) of Victoria (nearest town)

WELL PURPOSE: Home
(home, irrigation, municipal, industrial)

WELL COMPLETION DATA:
(1) diameter (inches) 4"
(2) total depth (feet) 110
(3) static water level (feet) 60 below top of ground.
(4) casing plastic 100 (material) (depth)
4" (size) if telescope see back.
(5) screen 10' 100 (length) (depth to top)
4" 0/3 plastic (size) (material)
(6) pump 1/2 17 (HP) (yield gpm)
Electric (type power)
(7) electric log no (yes or no)
(organization-running log)
(8) how well bottom plugged plastic cap

description of formations encountered	from	to
Topsoil & clay	0	16
sand	16	62
clay	62	66
sand	66	80
clay	80	85
sand	85	110


RECEIVED
SEP 12 1977

WATER COMMISSION

DRILLERS' REMARKS:

If well telescopes please sketch and show depths.

GROUND LEVEL

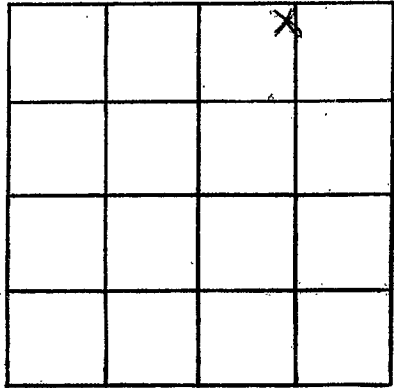

SECTION 25

Please indicate well location X.

ADDITIONAL INFORMATION

If more than one screen, show locations of each on sketch.