

Marshall
E 2018
11/15/77

MISSISSIPPI
BOARD OF WATER COMMISSIONERS
416 North State Street
Jackson, Mississippi 39201

WATER WELL DRILLERS LOG

11/15 1977 Alch Well Co Marshall
date well completed firm name county well located

LANDOWNER: Betty Brooks

description of formations encountered	from	to
---------------------------------------	------	----

Victoria, Ms.
(mailing address)

<u>Red sand + clay</u>	<u>0</u>	<u>60</u>
------------------------	----------	-----------

WELL LOCATION:
34 sec 7 T 2 S R 7 E
1/2 miles N of Victoria
(distance) (direction) (nearest town)

<u>White Sand + Clay</u>	<u>60</u>	<u>100</u>
--------------------------	-----------	------------

<u>White Sand</u>	<u>100</u>	<u>140</u>
-------------------	------------	------------

← Victoria

WELL PURPOSE: Home
(home, irrigation, municipal, industrial)

WELL COMPLETION DATA:

- (1) diameter (inches) 4"
- (2) total depth (feet) 140'
- (3) static water level (feet) 90' below top of ground.
- (4) casing PVC, 140'
(material) (depth)
(size) If telescope see back.
- (5) screen 7', 133'
(length) (depth to top)
7', gravel type
(size) (material)
- (6) pump 1/2, 10
(HP) (yield gpm)
220V
(type power)
- (7) electric log No
(yes or no)
- (organization running log)
- (8) how well bottom plugged Cap


DRILLERS REMARKS:

RECEIVED

NOV 30 1977

If well telescopes please sketch and show depths.

GROUND LEVEL

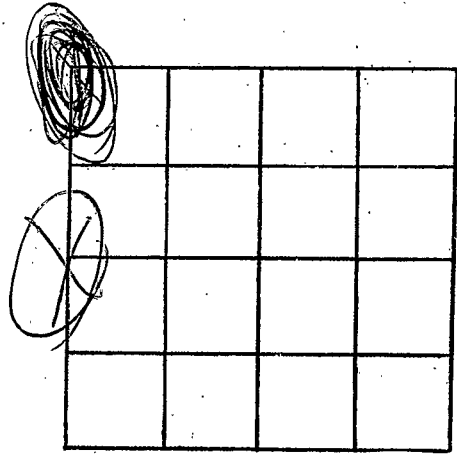

SECTION

24

Please indicate well location X.

ADDITIONAL INFORMATION

If more than one screen,
show locations of each on sketch.