

MARSHALL

E 2019

4-5-78

MISSISSIPPI BOARD OF WATER COMMISSIONERS
416 North State Street
Jackson, Mississippi 39201

WATER WELL DRILLERS LOG

4-5-

1978 Earl Jones Well Co.

Marshall

date well completed

firm name

county well located

LANDOWNER:

Sandy Holt

Collierville Tn. Rt
(mailing address)

WELL LOCATION:

sec. 3 T. 2 N R. 4 E
1 miles S.E. of Cayce
(distance) (direction) (nearest town)

WELL PURPOSE: home
(home, irrigation, municipal, industrial)

WELL COMPLETION DATA:

- (1) diameter (inches) 4"
- (2) total depth (feet) 120
- (3) static water level (feet) 80 below top of ground.
- (4) casing plastic 110
(material) (depth)
4" (size) if telescope see back.
- (5) screen 10' 110
(length) (depth to top)
- (6) pump 1/2 18
(HP) (yield gpm)
Electric (type power)
- (7) electric log no.
(yes or no)
- (8) how well bottom plugged plastic exp

description of formations encountered

from to

Topsail & clay	0	10
sand	10	18
clay	18	40
sand	40	65
clay	65	90
sand	90	120


RECEIVED
MAY 4 - 1978

DRILLERS REMARKS:

MISS. BD. OF WATER COMM

If well telescopes please sketch and show depths.

GROUND LEVEL

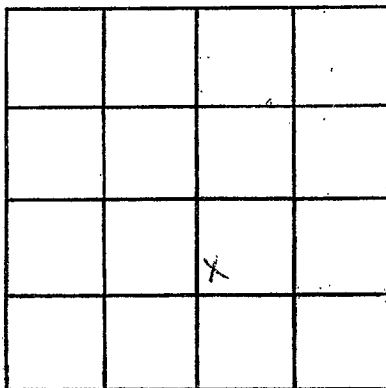

SECTION 3

Please indicate well location X.

ADDITIONAL INFORMATION

If more than one screen,
show locations of each on sketch.