


MARSHALL
E
2021

**MISSISSIPPI  
BOARD OF WATER COMMISSIONERS**  
416 North State Street  
Jackson, Mississippi 39201

**WATER WELL DRILLERS LOG**

July 11 1978 Earl Jones Well Co. Marshall  
 date well completed firm name county well located

LANDOWNER:	description of formations encountered	from	to
<u>Wadell Water</u>			
<u>Red Banks Miss. Rt 1</u> (mailing address)	<u>Topsoil &amp; clay</u>	<u>0</u>	<u>14</u>
	<u>sand</u>	<u>14</u>	<u>22</u>
	<u>clay</u>	<u>22</u>	<u>40</u>
	<u>sand #1</u>	<u>40</u>	<u>95</u>
	<u>clay</u>	<u>95</u>	<u>104</u>
	<u>sand #2</u>	<u>104</u>	<u>132</u>
<b>WELL LOCATION:</b> sec <u>36</u> T <u>2</u> N R <u>4</u> E <u>3 1/4</u> miles S of <u>Red Banks</u> (distance) (direction) (nearest town)			
<b>WELL PURPOSE:</b> <u>Homes</u> (home, irrigation, municipal, industrial)			
<b>WELL COMPLETION DATA:</b>			
(1) diameter (inches) <u>4"</u>			
(2) total depth (feet) <u>132</u>			
(3) static water level (feet) <u>75</u> below above top of ground.			
(4) casing <u>plastic</u> <u>122</u> (material) (depth) <u>4"</u> (size) if telescope see back.			
(5) screen <u>10'</u> <u>122</u> (length) (depth to top) <u>4-013</u> <u>plastic</u> (size) (material)			
(6) pump <u>1/2</u> <u>17</u> (HP) (yield gpm) <u>Electric</u> (type power)			
(7) electric log <u>no</u> (yes or no)  (organization running log)			
(8) how well bottom plugged <u>plastic caps</u>			
<b>DRILLERS REMARKS:</b>			

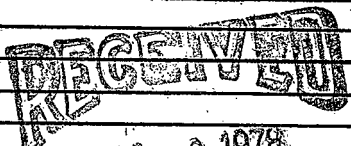


AUG 3 1978

MISS. BD. OF WATER COMMISSIONERS

If well telescopes please sketch and show depths.

GROUND LEVEL

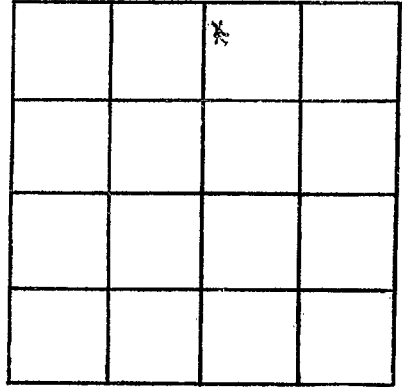

SECTION 36

Please indicate well location X.

ADDITIONAL INFORMATION

If more than one screen,  
show locations of each on sketch.