

MARSHALL

E 2022

MISSISSIPPI BOARD OF WATER COMMISSIONERS
416 North State Street
Jackson, Mississippi 39201

WATER WELL DRILLERS LOG

July 18, 1978
date well completed

Earl Jones Well Co
firm name

Marshall
county well located

LANDOWNER:

Hugh Bullock

description of formations encountered

from to

~~Red Banks~~ Red Banks Miss Rt
(mailing address)

Top soil of clay
sand
clay
sandst.

0 22
22 56
56 90
90 143

WELL LOCATION:

sec. 34 T 2 N R 4 E
S W
2 3/4 miles NE of Victoria
(distance) (direction) (nearest town)

WELL PURPOSE: Home
(home, irrigation, municipal, industrial)

WELL COMPLETION DATA:

- (1) diameter (inches) 4"
- (2) total depth (feet) 143
- (3) static water level (feet) 125 below top of ground.
- (4) casing plastic 133
(material) (depth)
4" (size) if telescope see back.
- (5) screen 10' 133
(length) (depth to top)
4" O.D. plastic
(size) (material)
- (6) pump 1/2 16
(HP) (yield gpm)
Electric
(type power)
- (7) electric log no
(yes or no)

(organization running log)

(8) how well bottom plugged
P. Collins Corp

DRILLERS REMARKS:


RECEIVED

AUG - 3 1978

MISS. BD. OF WATER COMMISSIONERS

If well telescopes please sketch and show depths.

GROUND LEVEL

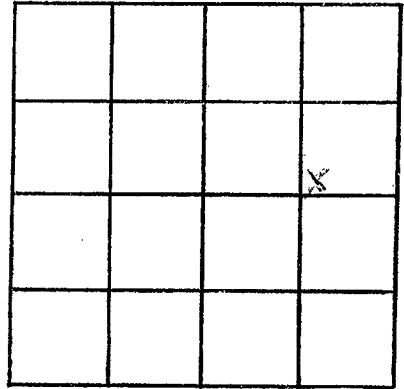

SECTION 34

Please indicate well location X.

ADDITIONAL INFORMATION

If more than one screen,
show locations of each on sketch.