

MARSHALL

E 2023

8-26-78

MISSISSIPPI BOARD OF WATER COMMISSIONERS
416 North State Street
Jackson, Mississippi 39201

WATER WELL DRILLERS LOG

8-26-78
date well completed

Hicks well CO
firm name

Marshall
county well located

LANDOWNER: Joe MOFFITT

RT-1 BOX 363

Bohaid MISS
(mailing address)

WELL LOCATION:

sec 21 T 2 N R 4 E
2 1/2 miles N of VICTORIE
(distance) (direction) (nearest town)

WELL PURPOSE: Home
(home, irrigation, municipal, industrial)

WELL COMPLETION DATA:

- (1) diameter (inches) 4"
- (2) total depth (feet) 140
- (3) static water level (feet) 60 below above top of ground.
- (4) casing PVC 140 (material) (depth)
if telescope see back.
(size)
- (5) screen 7' 7' (length) (depth to top)
4" Inside Rock (size) (material)
- (6) pump 10 10 (HP) (yield gpm)
220 E.P.C. (type power)
- (7) electric log (yes or no)
(organization running log)
- (8) how well bottom plugged CAP

description of formations encountered

from to

	RC	0	15
	WC & S	15	60
	W.S	60	90
	WC & S	90	120
	W.S	120	140


DRILLERS REMARKS:

RECEIVED
SEP 25 1978

MISS. BD. OF WATER COMMISSIONERS

If well telescopes please sketch and show depths.

GROUND LEVEL

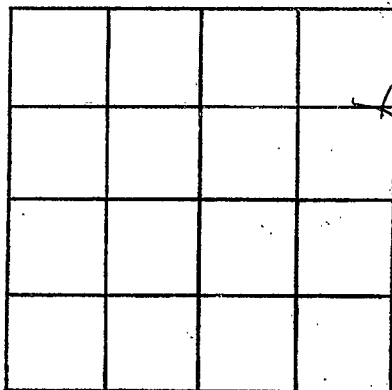

SECTION _____

Please indicate well location X.

ADDITIONAL INFORMATION

If more than one screen, show locations of each on sketch.