

MARSHALL  
 E  
 12-01-78  
 2025

MISSISSIPPI  
 BOARD OF WATER COMMISSIONERS  
 416 North State Street  
 Jackson, Mississippi 39201

WATER WELL DRILLERS LOG

12-1 1978  
 date well completed

*Water & Wilson Well Co.*  
 firm name

*Des. TA*  
 county well located

LANDOWNER:  
*Deotis Foreman*  
 2921 Hunter Rd.  
 Nesbitt, Miss  
 (mailing address)

description of formations encountered	from	to
<i>Red clay</i>	0	30
<i>Red sand</i>	30	40
<i>Red sand gravel</i>	40	75
<i>Red sand</i>	75	90
<i>Blue clay</i>	90	105
<i>Blue clay</i>	105	200
<i>Blue clay white sand</i>	200	250
<i>White sand</i>	200	300

WELL LOCATION:  
 sec. 14 T. 2 N. R. 4E  
 (distance) miles of (direction) of (nearest town) *?*

WELL PURPOSE:  
 (home, irrigation, municipal, industrial)

WELL COMPLETION DATA:  
 (1) diameter (inches) 4  
 (2) total depth (feet) 292  
 (3) static water level (feet) 100 below top of ground.  
 (4) casing IN 292 (material) (depth)  
4 If telescope see back. (size)  
 (5) screen 10 282 (length) (depth to top)  
4 gravel packed (size) (material)  
 (6) pump 3/4 10 (HP) (yield gpm)  
electric (type power)  
 (7) electric log \_\_\_\_\_ (yes or no)  
 \_\_\_\_\_ (organization running log)


(8) how well bottom plugged 4"  
*plaster cap*

DRILLERS REMARKS:

RECEIVED  
 JAN 15 1978  
 MISS. BD. OF WATER COMMISSIONERS

If well telescopes please sketch and show depths.

GROUND LEVEL

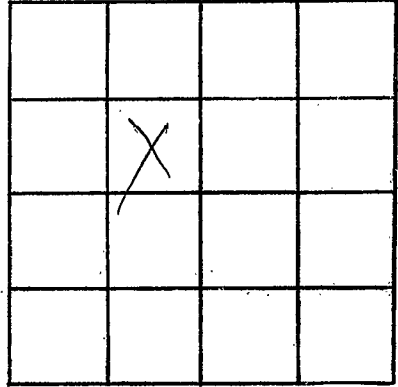

SECTION 19

Please indicate well location X.

ADDITIONAL INFORMATION

If more than one screen, show locations of each on sketch.