

MARSHALL
E 226

MISSISSIPPI
BOARD OF WATER COMMISSIONERS
416 North State Street
Jackson, Mississippi 39201

WATER WELL DRILLERS LOG

12/19/78
Dec. 19 1978 R. L. Carpenter Marshall
date well completed firm name county well located

LANDOWNER: William P. Lofter
Red Boxy Truss
RFD
(mailing address)

description of formations encountered	from	to
Surface Soil	0	19
Med Red Sand	19	54
White Coarse Sand	54	98
White Clay	98	130
White Fine Sand	130	145
White Coarse Sand	145	190

WELL LOCATION:
sec. 12 T 2 N R 4 E
S W
4 miles SW of Mt. Pleasant
(distance) (direction) (nearest town)

WELL PURPOSE: Hog Barn
(home, irrigation, municipal, industrial)

- WELL COMPLETION DATA:
- (1) diameter (inches) 4
 - (2) total depth (feet) 190
 - (3) static water level (feet) 95 below top of ground.
 - (4) casing Plaster, 170'
(material) (depth)
(size) If telescope see back.
 - (5) screen 20', 170'
(length) (depth to top)
4", Plaster
(size) (material)
 - (6) pump 1 1/2 20
(HP) (yield gpm)
Elec.
(type power)
 - (7) electric log no
(yes or no)
 - (organization running log)
 - (8) how well bottom plugged PVC cap


DRILLERS REMARKS:

DEPT. OF NATURAL RESOURCES
BUREAU OF LAND & WATER RESOURCES

MAY 18 1981
RECEIVED

If well telescopes please sketch and show depths.

GROUND LEVEL

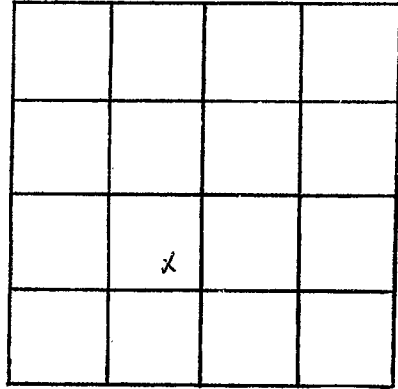

SECTION 12

Please indicate well location X.

ADDITIONAL INFORMATION

If more than one screen,
show locations of each on sketch.