

MARSHALL  
E 2028  
5-25-79

MISSISSIPPI  
BOARD OF WATER COMMISSIONERS  
416 North State Street  
Jackson, Mississippi 39201

WATER WELL DRILLERS LOG


5-25 date well completed  
1977 Deane Hart Benge well firm name  
Marshall county well located

LANDOWNER:	description of formations encountered	from	to
Lewis Clark Halls Springs, Miss. (mailing address)			
<b>WELL LOCATION:</b>			
sec. 21 T. 2 N. R. 4 E. 5 miles north of Victoria (distance) (direction) (nearest town)			
<b>WELL PURPOSE:</b> <u>drinking</u> (home, irrigation, municipal, industrial)			
<b>WELL COMPLETION DATA:</b>			
(1) diameter (inches) <u>4"</u>			
(2) total depth (feet) <u>160 feet</u>			
(3) static water level (feet) <u>25 ft</u> below above top of ground.			
(4) casing <u>PVC</u> <u>160 feet</u> (material) (depth)			
(size) if telescope see back.			
(5) screen <u>20 ft</u> , <u>153 ft</u> (length) (depth to top)			
<u>4"</u> , <u>grooved wood</u> (size) (material)			
(6) pump <u>3/4</u> <u>14</u> (HP) (yield gpm)			
(type power)			
(7) electric log <u>elect.</u> (yes or no)			
(organization running log)			
(8) how well bottom plugged <u>4" cap.</u>			
<b>DRILLERS REMARKS:</b>			

Miss. Board of Water Comm.  
JUN 8 1979  
RECEIVED

If well telescopes please sketch and show depths.

GROUND LEVEL

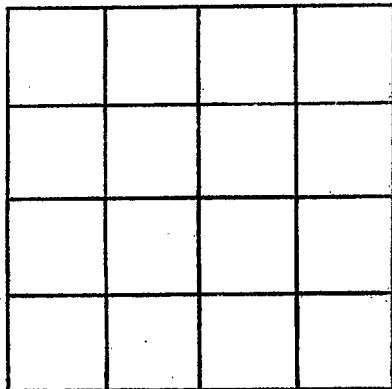

SECTION \_\_\_\_\_

Please indicate well location X.

ADDITIONAL INFORMATION

If more than one screen, show locations of each on sketch.