

MARSHALL

E 2029

3-28-79

MISSISSIPPI
BOARD OF WATER COMMISSIONERS
416 North State Street
Jackson, Mississippi 39201

WATER WELL DRILLERS LOG

3-28 1979
date well completed

Dentrest Drilling well
firm name

Marshall
county well located

LANDOWNER:

Allen J. Reed

Byhalia, miss
(mailing address)

description of fomations encountered

clay

from

to

0 14

sand

14 87

WELL LOCATION:

sec. 22 T. 2 N. R. 4 E.
7 miles North of Victor
(distance) (direction) (nearest town)

WELL PURPOSE: Drilling
(home, irrigation, municipal, industrial)

WELL COMPLETION DATA:

- (1) diameter (inches) 4"
- (2) total depth (feet) 87 feet
- (3) static water level (feet) 73 below top of ground.
- (4) casing PVC 87 feet
(material) (depth)

(size) if telescope see back.

- (5) screen 74" 80 feet
(length) (depth to top)
- 4" ground well
(size) (material)

- (6) pump 3/4 14
(HP) (yield gpm)

(type power)

- (7) electric log flat
(yes or no)

(organization running log)

- (8) how well bottom plugged 4" ap.

DRILLERS REMARKS:


Miss. Board of Water Comm.

MAY 21 1979

RECEIVED

If well telescopes please sketch and show depths.

GROUND LEVEL

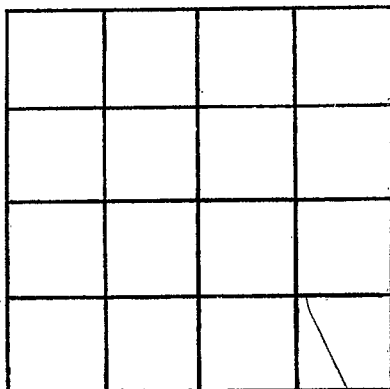

SECTION _____

Please indicate well location X.

ADDITIONAL INFORMATION

If more than one screen, show locations of each on sketch.