

MARSHALL

E

7-20-79

2030

MISSISSIPPI  
BOARD OF WATER COMMISSIONERS  
416 North State Street  
Jackson, Mississippi 39201

WATER WELL DRILLERS LOG

July 20  
date well completed

1979 Earl Jones Well Co  
firm name

Marshall  
county well located

LANDOWNER:

Artie Pritchard

Red Banks Miss. Rt. 1  
(mailing address)

WELL LOCATION:

sec. 35 T 2 N R 4 E  
S W  
3 miles N of Victoria  
(distance) (direction) (nearest town)

WELL PURPOSE: Home  
(home, irrigation, municipal, industrial)

WELL COMPLETION DATA:

- (1) diameter (inches) 4"
- (2) total depth (feet) 120
- (3) static water level (feet) 100 below top of ground.
- (4) casing plastic 110 (material), (depth), 4" (size) if telescope see back.
- (5) screen 10' 110 (length), (depth to top) 4" 013 plastic (size), (material)
- (6) pump 1/2 15 (HP), (yield gpm) electric (type power)
- (7) electric log no (yes or no)

(organization running log)

(8) how well bottom plugged plastic cap

DRILLERS REMARKS:

description of formations encountered

from to

Topsail & clay sand.	0	18
clay	18	28
clay sand.	28	43
clay sand.	43	65
clay sand.	65	70
clay sand.	70	120


Miss. Board of Water Comm

JUL 30 1979

RECEIVED

If well telescopes please sketch and show depths.

GROUND LEVEL

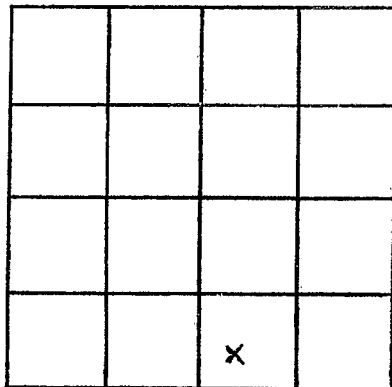

SECTION 35

Please indicate well location X.

ADDITIONAL INFORMATION

If more than one screen,  
show locations of each on sketch.