

MARSHALL
E 2031
7-12-79

**MISSISSIPPI  
BOARD OF WATER COMMISSIONERS**  
416 North State Street  
Jackson, Mississippi 39201

**WATER WELL DRILLERS LOG**

July 12, 1979 Earl Jones Well Co. Marshall  
 date well completed firm name county well located

LANDOWNER:	description of formations encountered	from	to
<u>Louis Chappel</u>			
<u>Byhalia Miss. Rt.</u> (mailing address)	<u>Topsoil of clay</u>	<u>0</u>	<u>14</u>
	<u>sand</u>	<u>14</u>	<u>30</u>
	<u>clay</u>	<u>30</u>	<u>35</u>
	<u>sand</u>	<u>35</u>	<u>60</u>
	<u>clay</u>	<u>60</u>	<u>65</u>
	<u>sand</u>	<u>65</u>	<u>110</u>
<b>WELL LOCATION:</b> sec <u>26</u> T <u>2</u> N R <u>4</u> E <u>3 1/2</u> miles <sup>S</sup> of <u>Victoria</u> (distance) (direction) (nearest town)			
<b>WELL PURPOSE:</b> <u>Home</u> (home, irrigation, municipal, industrial)			
<b>WELL COMPLETION DATA:</b>			
(1) diameter (inches) <u>4"</u>			
(2) total depth (feet) <u>110</u>			
(3) static water level (feet) <u>74</u> below above top of ground.			
(4) casing <u>plastic</u> , <u>100</u> (material), (depth), <u>4"</u> (size) if telescope see back.			
(5) screen <u>10'</u> , <u>100</u> (length), (depth to top) <u>4" - 013</u> , <u>plastic</u> (size), (material)			
(6) pump <u>1/2</u> , <u>16</u> (HP), (yield gpm) <u>electric</u> (type power)			
(7) electric log <u>no</u> (yes or no)			
(organization running log)			
(8) how well bottom plugged <u>plastic cap</u>			
<b>DRILLERS REMARKS:</b>			


Miss. Board of Water Comm.

JUL 30 1979

RECEIVED

If well telescopes please sketch and show depths.

GROUND LEVEL

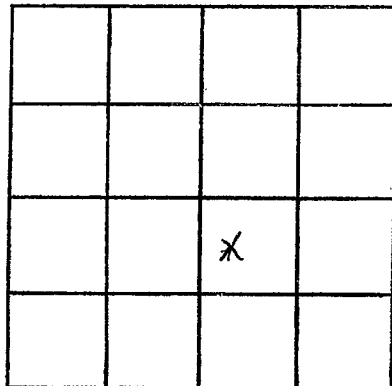

SECTION 26

Please indicate well location X.

ADDITIONAL INFORMATION

If more than one screen,  
show locations of each on sketch.