

Marshall
E 2032

MISSISSIPPI
BOARD OF WATER COMMISSIONERS
416 North State Street
Jackson, Mississippi 39201

11-26-79


WATER WELL DRILLERS LOG

Nov 26 1979 date well completed
Earl Jones Well Co firm name
Marshall county well located

LANDOWNER:	description of formations encountered	from	to
H.R. McCrocker			
Byholts miss. Rt 1 (mailing address)	Top soil of clay	0	13
	Sand	18	45
	clay	45	60
	sand	60	95
	clay	95	138
	Sand	138	160
WELL LOCATION: sec 34 T 2 N R 4 E S W 1 3/4 miles NE of Victoria (distance) (direction) (nearest town)			
WELL PURPOSE: Home (home, irrigation, municipal, industrial)			
WELL COMPLETION DATA:			
(1) diameter (inches) 4"			
(2) total depth (feet) 160			
(3) static water level (feet) 140 below top of ground.			
(4) casing plastic 150 (material) (depth)			
4" (size) if telescope see back.			
(5) screen 10' 150 (length) (depth to top)			
0.13-4" plastic (size) (material)			
(6) pump 3/4 18 (HP) (yield gpm)			
electric (type power)			
(7) electric log no (yes or no)			
(organization running log)			
(8) how well bottom plugged plastic cap			
DRILLERS REMARKS:	Rec'd J.W. 12-27-79		

If well telescopes please sketch and show depths.

GROUND LEVEL

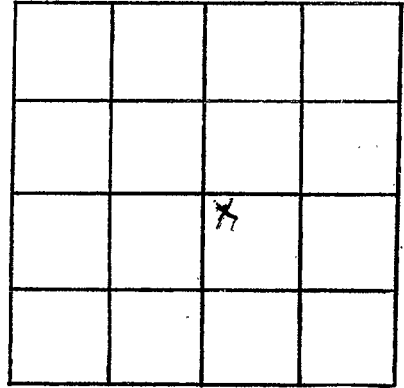

SECTION 24

Please indicate well location X.

ADDITIONAL INFORMATION

If more than one screen,
show locations of each on sketch.