

Marshall

E 2035

**MISSISSIPPI
BOARD OF WATER COMMISSIONERS**
416 North State Street
Jackson, Mississippi 39201

8/17/80

Aug 17

1980 R. L. Carpenter

Marshall

date well completed

firm name

county well located

WATER WELL DRILLERS LOG

LANDOWNER: Jep L. Young

Victoria, Miss

RFD

(mailing address)

WELL LOCATION:

sec 26 T 2 N R 4 E
 S W
3 miles North of Victoria
 (distance) (direction) (nearest town)

WELL PURPOSE: Home
 (home, irrigation, municipal, industrial)

WELL COMPLETION DATA:

- (1) diameter (inches) 4
- (2) total depth (feet) 118
- (3) static water level (feet) 65 below above top of ground.
- (4) casing Plastic 108'
 (material) (depth)
 if telescope see back.
 (size)
- (5) screen 10'
 (length) (depth to top)
4" Plastic
 (size) (material)
- (6) pump 1/4 10
 (HP) (yield gpm)
Elec
 (type power)
- (7) electric log no
 (yes or no)

 (organization running log)
- (8) how well bottom plugged Pvc Cap


description of formations encountered	depth	
	from	to
<u>Surface Soil</u>	<u>0</u>	<u>15</u>
<u>red Red Sand</u>	<u>15</u>	<u>40</u>
<u>red white Sand</u>	<u>40</u>	<u>69</u>
<u>white clay</u>	<u>69</u>	<u>85</u>
<u>white coarse Sand</u>	<u>85</u>	<u>118</u>

DRILLERS REMARKS:

DEPT. OF NATURAL RESOURCES
 BUREAU OF LAND & WATER RESOURCES
 MAY 18 1981
RECEIVED

If well telescopes please sketch and show depths.

GROUND LEVEL

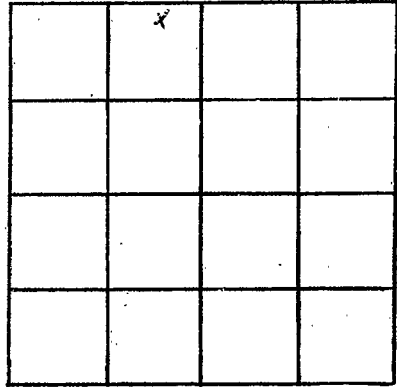

SECTION 26

Please indicate well location X.

ADDITIONAL INFORMATION

If more than one screen,
show locations of each on sketch.