

MISSISSIPPI DEPARTMENT OF NATURAL RESOURCES
Bureau of Land and Water Resources
 Southport Mall
 P.O. Box 10631
 Jackson, Mississippi 39209
WATER WELL DRILLERS LOG

Marshall
E 2041
11-5-80

11-5 1980 Hicks Well Co. Marshall
 date well completed firm name county well located


LANDOWNER: <u>Wayne Ryan</u> <u>P.O. Box 198</u>	description of formations encountered	from	to
<u>Victoria, Ms.</u> (mailing address)	<u>Red Clay</u>	<u>0</u>	<u>10</u>
WELL LOCATION: sec. <u>27</u> T. <u>2</u> N R. <u>4</u> E <u>3</u> miles <u>N</u> of <u>Victoria</u> (distance) (direction) (nearest town)	<u>White Sand</u>	<u>10</u>	<u>125</u>
WELL PURPOSE: <u>Home</u> (home, irrigation, municipal, industrial)			
WELL COMPLETION DATA:			
(1) diameter (inches) <u>4</u>			
(2) total depth (feet) <u>125</u>			
(3) static water level (feet) <u>90</u> below above top of ground.			
(4) casing <u>PVC</u> <u>125</u> (material) (depth)			
<u> </u> if telescope see back. (size)			
(5) screen <u>7</u> <u>118</u> (length) (depth to top)			
<u>4"</u> <u>orange tape</u> (size) (material) <u>0'</u>			
(6) pump <u>1/2</u> <u>10</u> (HP) (yield gpm)			
<u>220V</u> (type power)			
(7) electric log <u>No</u> (yes or no)			
<u> </u> (organization running log)			
(8) how well bottom plugged <u>Cap</u>			
DRILLERS REMARKS:			

DEPT. OF NATURAL RESOURCES
 BUREAU OF LAND & WATER RESOURCES

DEC 3 1980
RECEIVED

If well telescopes please sketch and show depths.

GROUND LEVEL

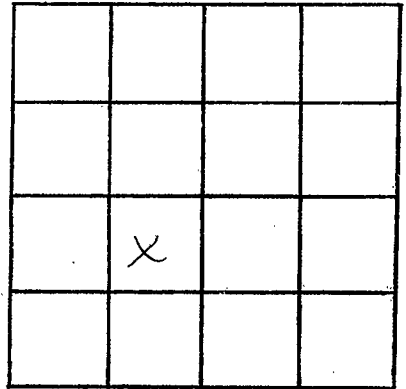

SECTION 27

Please indicate well location X.

ADDITIONAL INFORMATION

If more than one screen, show locations of each on sketch.