

MARSHALL  
E 2042  
11-4-80

MISSISSIPPI  
 BOARD OF WATER COMMISSIONERS  
 416 North State Street  
 Jackson, Mississippi 39201

WATER WELL DRILLERS LOG

11-4 1980 Hick Well Co. Marshall  
 date well completed firm name county well located

LANDOWNER: Turner Luttell  
Rt. 1, Box 410CC98  
Byhalia, Ms.  
 (mailing address)

description of formations encountered	from	to
<u>Red clay</u>	<u>0</u>	<u>15</u>
<u>white sand</u>	<u>15</u>	<u>125</u>

WELL LOCATION:  
 sec 27 T 2 N R 4 E  
3 miles N of Victor  
 (distance) (direction) (nearest town)

WELL PURPOSE: Home  
 (home, irrigation, municipal, industrial)


- WELL COMPLETION DATA:
- (1) diameter (inches) 4
  - (2) total depth (feet) 125
  - (3) static water level (feet) 90 below above top of ground.
  - (4) casing PVC 125  
 (material) (depth)  
 (size) if telescope see back.
  - (5) screen 7 118  
 (length) (depth to top)  
2" cravel mesh  
 (size) (material)
  - (6) pump 1/2 10  
 (HP) (yield gpm)  
220V  
 (type power)
  - (7) electric log No  
 (yes or no)  
 (organization running log)
  - (8) how well bottom plugged Cap

DRILLERS REMARKS:

DEPT. OF NATURAL RESOURCES  
 BUREAU OF LAND & WATER RESOURCES  
 DEC 3 1980  
 RECEIVED

If well telescopes please sketch and show depths.

GROUND LEVEL

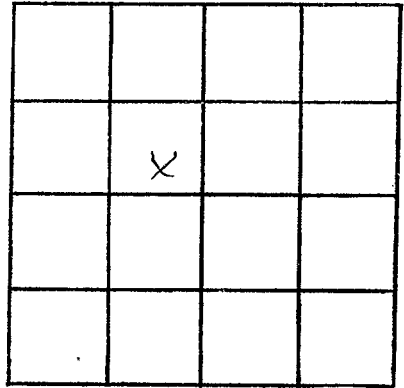

SECTION 27

Please indicate well location X.

ADDITIONAL INFORMATION

If more than one screen,  
show locations of each on sketch.