

Marshall
E 2043
11-3-80

MISSISSIPPI
BOARD OF WATER COMMISSIONERS
416 North State Street
Jackson, Mississippi 39201

WATER WELL DRILLERS LOG

11-3 1980 Hicks Well Co. Marshall
date well completed firm name county well located


LANDOWNER: <u>C. Donald H. Thompson</u> <u>Rt. 1, Box 410000</u>	Description of formations encountered	from	to
<u>Buhala, Mrs.</u> (mailing address)	<u>Red clay</u>	<u>0</u>	<u>10</u>
WELL LOCATION: sec <u>27</u> T <u>2</u> N R <u>4</u> E <u>3</u> miles N of <u>Victoria</u>	<u>Co. & sand</u>	<u>10</u>	<u>125</u>
(distance) (direction) (nearest town)	<u>White clay</u>	<u>125</u>	<u>155</u>
WELL PURPOSE: <u>Home</u> (home, irrigation, municipal, industrial)	<u>White sand</u>	<u>155</u>	<u>185</u>
WELL COMPLETION DATA:			
(1) diameter (inches) <u>4</u>			
(2) total depth (feet) <u>185</u>			
(3) static water level (feet) <u>90</u> below above top of ground.			
(4) casing <u>PVC</u> , <u>185</u> , (material) (depth)			
_____ if telescope see back. (size)			
(5) screen <u>7</u> , <u>178</u> (length) (depth to top)			
<u>4"</u> , <u>gravel type</u> (size) (material)			
(6) pump <u>1/2</u> , <u>10</u> (HP) (yield gpm) <u>220V</u> (type power)			
(7) electric log <u>No</u> (yes or no)			
_____ (organization running log)			
(8) how well bottom plugged <u>Cap</u>			
DRILLERS REMARKS:			

DEPT. OF NATURAL RESOURCES
BUREAU OF LAND & WATER RESOURCES

DEC - 3 1980
RECEIVED

If well telescopes please sketch and show depths.

GROUND LEVEL

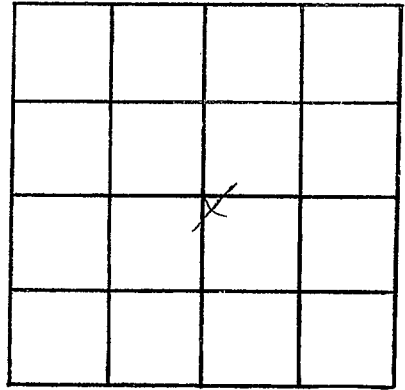

SECTION 27

Please indicate well location X.

ADDITIONAL INFORMATION

If more than one screen,
show locations of each on sketch.