

MARSHALL  
E 2044  
10-14-80

MISSISSIPPI  
 BOARD OF WATER COMMISSIONERS  
 416 North State Street  
 Jackson, Mississippi 39201

WATER WELL DRILLERS LOG

Oct 14 1980 Earl Jones Well Co. Marshall  
 date well completed firm name county well located


LANDOWNER:	description of formations encountered	from	to
<u>Sandy Paulsen</u> <u>Victoria Miss.</u> (mailing address)			
	<u>sand.</u>	<u>16</u>	<u>27</u>
	<u>clay</u>	<u>27</u>	<u>40</u>
	<u>sand</u>	<u>40</u>	<u>70</u>
	<u>clay</u>	<u>70</u>	<u>76</u>
	<u>sand</u>	<u>76</u>	<u>110</u>
WELL LOCATION: sec. <u>22</u> <u>2</u> <u>N</u> R <u>4</u> <u>E</u> <u>3</u> miles <u>N.</u> of <u>Victoria</u> (distance) (direction) (nearest town)			
WELL PURPOSE: <u>Home</u> (home, irrigation, municipal, industrial)			
WELL COMPLETION DATA:			
(1) diameter (inches) <u>4"</u>			
(2) total depth (feet) <u>110</u>			
(3) static water level (feet) <u>85</u> below top of ground.			
(4) casing <u>plastic</u> <u>100</u> (material) (depth) <u>4"</u> (size) if telescope see back.			
(5) screen <u>10'</u> <u>100</u> (length) (depth to top) <u>0 13-4"</u> <u>plastic</u> (size) (material)			
(6) pump <u>1/2</u> <u>15</u> (HP) (yield gpm) <u>electric</u> (type power)			
(7) electric log <u>no</u> (yes or no)  (organization running log)			
(8) how well bottom plugged <u>plastic cap</u>			
DRILLERS REMARKS:			

DEPT. OF NATURAL RESOURCES  
 BUREAU OF LAND & WATER RESOURCES

NOV 19 1980  
 RECEIVED

If well telescopes please sketch and show depths.

GROUND LEVEL

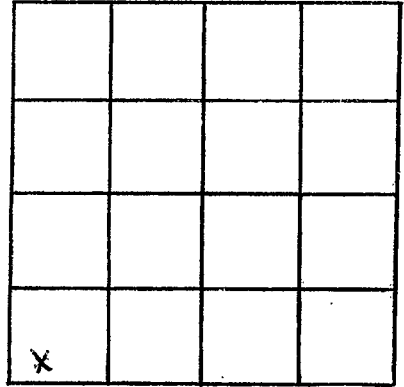

SECTION 22

Please indicate well location X.

ADDITIONAL INFORMATION

If more than one screen, show locations of each on sketch.