

MARSHALL
E 2045
6-12-80

MISSISSIPPI
 BOARD OF WATER COMMISSIONERS
 416 North State Street
 Jackson, Mississippi 39201

WATER WELL DRILLERS LOG

6/12/80 19 1980 By [Signature] Marshall
 date well completed firm name county well located

LANDOWNER:

Victor Coste
Victoria, Mo.
 (mailing address)

description of formations encountered

from to

top soil 0 5
rd. clay 5 40
white sand 40 130

WELL LOCATION:

sec 36 T 2 N R 4 E
S W
13 miles W of Victoria
 (distance) (direction) (nearest town)

WELL PURPOSE:

(home, irrigation, municipal, industrial)

WELL COMPLETION DATA:

- (1) diameter (inches) 4"
- (2) total depth (feet) 130'
- (3) static water level (feet) 95' (below) above top of ground.
- (4) casing plastic, 130'
 (material) (depth)
 (size) if telescope see back.
- (5) screen 10', 130'
 (length) (depth to top)
4", plastic
 (size) (material)
- (6) pump 1/2, 10
 (HP) (yield gpm)
elec.
 (type power)

(7) electric log (yes or no)

(organization running log)

(8) how well bottom plugged cap

DRILLERS REMARKS:


DEPT. OF NATURAL RESOURCES
 BUREAU OF LAND & WATER RESOURCES

OCT 15 1980

RECEIVED

If well telescopes please sketch and show depths.

GROUND LEVEL

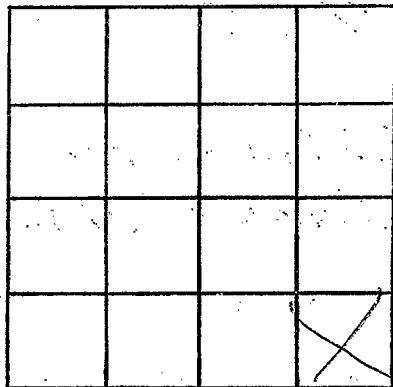

SECTION _____

Please indicate well location X.

ADDITIONAL INFORMATION

If more than one screen, show locations of each on sketch.