

MISSISSIPPI DEPARTMENT OF NATURAL RESOURCES

Bureau of Land and Water Resources

Southport Mall

P.O. Box 10631

Jackson, Mississippi 39209

WATER WELL DRILLERS LOG

MARSHALL  
E 2046  
1-5-81

date well completed 1-5 1981 firm name Hicks Well Co. county well located Marshall

LANDOWNER: Jordan Key  
Box 3 Marcus Farms  
Bayou Vista Ms.  
(mailing address)

description of formations encountered	from	to
<u>Red Clay</u>	<u>0</u>	<u>10</u>
<u>Clay &amp; sand</u>	<u>10</u>	<u>95</u>
<u>White sand</u>	<u>95</u>	<u>125</u>

WELL LOCATION:  
sec. 22 T 2 N R 4 E  
3 miles N of Victoria  
(distance) (direction) (nearest town)

WELL PURPOSE: Home  
(home, irrigation, municipal, industrial)

- WELL COMPLETION DATA:
- (1) diameter (inches) 4
  - (2) total depth (feet) 125
  - (3) static water level (feet) 80 below above top of ground.
  - (4) casing PVC 125  
(material) (depth)
  - if telescope see back.  
(size)
  - (5) screen 7 118  
(length) (depth to top)
  - 4" concrete type  
(size) (material)
  - (6) pump 1/2 10  
(HP) (yield gpm)
  - 220V  
(type power)
  - (7) electric log No  
(yes or no)
  - (organization running log)
  - (8) how well bottom plugged Cap


DRILLERS REMARKS:

DEPT. OF NATURAL RESOURCES  
BUREAU OF LAND & WATER RESOURCES

FEB 12 1981  
RECEIVED

If well telescopes please sketch and show depths.

GROUND LEVEL

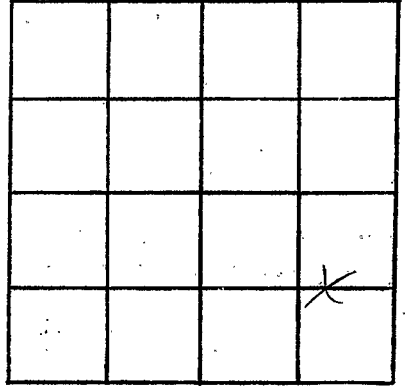

SECTION 27

Please indicate well location X.

ADDITIONAL INFORMATION

If more than one screen, show locations of each on sketch.