

MISSISSIPPI DEPARTMENT OF NATURAL RESOURCES

Bureau of Land and Water Resources

Southport Mall

P.O. Box 10631

Jackson, Mississippi 39209

WATER WELL DRILLERS LOG

MARSHALL
E 2047
11-28-80

11-28 1980 Hick Well Co. Marshall
date well completed firm name county well located

LANDOWNER: Charles Jackson
Rt. 1 Macon Farms
Bellevue, Ms.
(mailing address)

description of formations encountered	from	to
<u>Red Clay</u>	<u>0</u>	<u>10</u>
<u>Clay + Sand</u>	<u>10</u>	<u>100</u>
<u>White Sand</u>	<u>100</u>	<u>140</u>

WELL LOCATION:

sec. 27 T 2 N R 4 E
3 miles N of Victoria
(distance) (direction) (nearest town)

WELL PURPOSE: None
(home, irrigation, municipal, industrial)

WELL COMPLETION DATA:

- (1) diameter (inches) 4
- (2) total depth (feet) 140
- (3) static water level (feet) 80 below above top of ground.
- (4) casing PVC, 140
(material) (depth)
- if telescope see back.
(size)
- (5) screen 7, 133
(length) (depth to top)
- 0.2, open end type
(size) (material)
- (6) pump 1/2, 10
(HP) (yield gpm)
- 220V
(type power)
- (7) electric log No
(yes or no)

(organization running log)

(8) how well bottom plugged Cap


DRILLERS REMARKS:

DEPT. OF NATURAL RESOURCES
BUREAU OF LAND & WATER RESOURCES

DEC 23 1980
RECEIVED

If well telescopes please sketch and show depths.

GROUND LEVEL

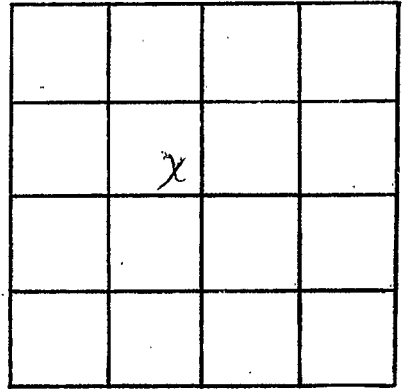

SECTION 27

Please indicate well location X.

ADDITIONAL INFORMATION

If more than one screen,
show locations of each on sketch.