

MISSISSIPPI DEPARTMENT OF NATURAL RESOURCES

Bureau of Land and Water Resources

Southport Mall

P.O. Box 10631

Jackson, Mississippi 39209

WATER WELL DRILLERS LOG

MARSHALL
E 2048
12-1-80

date well completed 12-1 19 80 firm name Hick Well Co. county well located Marshall

LANDOWNER: T. D. Meredith
Box 1 Mason Farms
Behndia, Ms.
 (mailing address)

description of formations encountered	from	to
	<u>Red Clay</u>	<u>0</u>
<u>Clay + Sand</u>	<u>10</u>	<u>80</u>
<u>White Sand</u>	<u>80</u>	<u>140</u>

WELL LOCATION:
 sec. 27 T. 2 N. R. 4 E. W
3 miles N of Victoria
 (distance) (direction) (nearest town)

WELL PURPOSE: Home
 (home, irrigation, municipal, industrial)

WELL COMPLETION DATA:

(1) diameter (inches) 4

(2) total depth (feet) 140

(3) static water level (feet) 80 below above top of ground.

(4) casing PVC, 140,
 (material) (depth)

— If telescope see back.
 (size)

(5) screen 7, 133
 (length) (depth to top)

02, gravel type
 (size) (material)

(6) pump 1/2, 10
 (HP) (yield gpm)

220V
 (type power)

(7) electric log No
 (yes or no)

—
 (organization running log)


(8) how well bottom plugged Cap

DRILLERS REMARKS:

DEPT. OF NATURAL RESOURCES
 BUREAU OF LAND & WATER RESOURCES
 DEC 29 1980
 RECEIVED

If well telescopes please sketch and show depths.

GROUND LEVEL

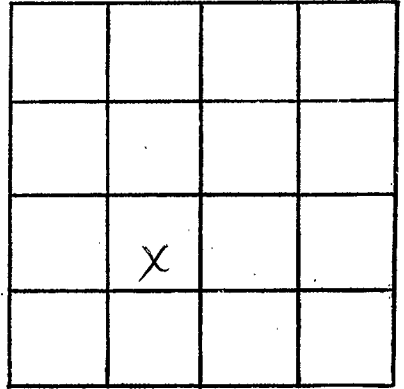

SECTION 29

Please indicate well location X.

ADDITIONAL INFORMATION

If more than one screen,
show locations of each on sketch.