

MISSISSIPPI DEPARTMENT OF NATURAL RESOURCES

Bureau of Land and Water Resources

Southport Mall

P.O. Box 10631

Jackson, Mississippi 39209

WATER WELL DRILLERS LOG

MARSHALL  
E 2049  
12-3-80

12/3 19 80 Hick Well Co. Marshall  
date well completed firm name county well located

LANDOWNER: <u>Johnny Hleser</u> <u>Pt. 1 Maroon Farms</u> <u>Bayou Vista, MS</u> (mailing address)	description of formations encountered	from	to
	<u>Red Clay</u>	<u>0</u>	<u>10</u>
	<u>Clay + Sand</u>	<u>10</u>	<u>90</u>
	<u>White Sands</u>	<u>90</u>	<u>140</u>
<b>WELL LOCATION:</b> sec <u>27</u> T <u>8</u> N <u>4</u> E (S) (NW) <u>3</u> miles N of <u>Victoria</u> (distance) (direction) (nearest town)			
<b>WELL PURPOSE:</b> <u>Home</u> (home, irrigation, municipal, industrial)			
<b>WELL COMPLETION DATA:</b>			
(1) diameter (inches) <u>4</u>			
(2) total depth (feet) <u>140</u>			
(3) static water level (feet) <u>80</u> below top of ground.			
(4) casing <u>PVC</u> , <u>140</u> (material) (depth)			
<u>        </u> if telescope see back. (size)			
(5) screen <u>7'</u> , <u>133</u> (length) (depth to top)			
<u>02</u> , <u>normal type</u> (size) (material)			
(6) pump <u>1/2</u> , <u>10</u> (HP) (yield gpm)			
<u>220V</u> (type power)			
(7) electric log <u>No</u> (yes or no)			
<u>        </u> (organization running log)			
(8) how well bottom plugged <u>Cap</u>			
DRILLERS REMARKS:			


DEPT. OF NATURAL RESOURCES  
BUREAU OF LAND & WATER RESOURCES

DEC 23 1980

RECEIVED

If well telescopes please sketch and show depths.

GROUND LEVEL

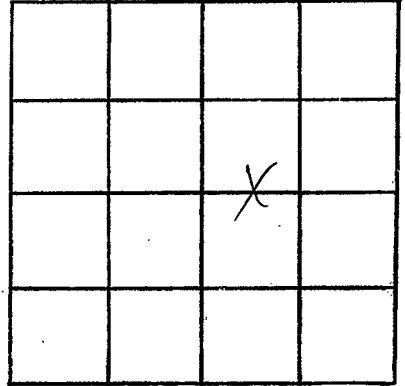

SECTION 27

Please indicate well location X.

ADDITIONAL INFORMATION

If more than one screen,  
show locations of each on sketch.