

MISSISSIPPI DEPARTMENT OF NATURAL RESOURCES

Bureau of Land and Water Resources

Southport Mall

P.O. Box 10631

Jackson, Mississippi 39209

WATER WELL DRILLERS LOG

<u>Marshall</u>
<u>E 2050</u>
<u>12-4-80</u>

date well completed 12/4 19 80 firm name Kick Well Co. county well located Marshall

LANDOWNER: Engene McCow

description of formations encountered

from to

Rt. 1 Macon Farm

Bubalia, Ms.
(mailing address)

Red clay 0 10

Clay + Sand 10 80

WELL LOCATION:

sec 27 T 2 N 4 E
(S) (W)
3 miles N of Victoria
(distance) (direction) (nearest town)

White sand 80 140

WELL PURPOSE: None
(home, irrigation, municipal, industrial)

WELL COMPLETION DATA:

- (1) diameter (inches) 4
- (2) total depth (feet) 140
- (3) static water level (feet) 65 below above top of ground.
- (4) casing PVC, 140
(material) (depth)

 if telescope see back.
(size)

- (5) screen 7, 133
(length) (depth to top)
- 02, gravel type
(size) (material)

- (6) pump 1/2, 10
(HP) (yield gpm)
- 220V
(type power)

- (7) electric log No
(yes or no)

(organization running log)

- (8) how well bottom plugged Cap

DEPT. OF NATURAL RESOURCES
BUREAU OF LAND & WATER RESOURCES


DEC 23 1980

RECEIVED

DRILLERS REMARKS:

If well telescopes please sketch and show depths.

GROUND LEVEL

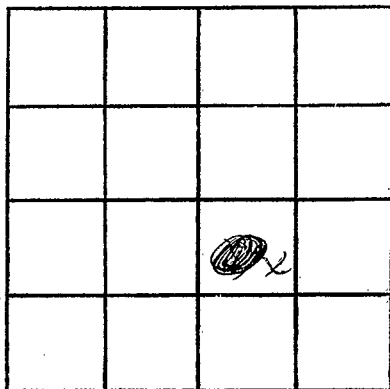

SECTION 27

Please indicate well location X.

ADDITIONAL INFORMATION

If more than one screen,
show locations of each on sketch.