

MISSISSIPPI DEPARTMENT OF NATURAL RESOURCES

Bureau of Land and Water Resources

Southport Mall

P.O. Box 10631

Jackson, Mississippi 39209

WATER WELL DRILLERS LOG

MARSHALL
E 2051
12-5-80

12/5 1980 Hick Well Co. Marshall
date well/completed firm name county well located

LANDOWNER: <u>Fanshella Hines</u>	description of formations encountered	from	to
<u>Rt. 1 Marcon Farms</u>			
<u>Bahalen Ms.</u> (mailing address)	<u>Red Clay</u>	<u>0</u>	<u>10</u>
WELL LOCATION: sec. <u>27</u> T <u>2</u> N R <u>4</u> E (distance) (direction) (nearest town)	<u>Clay + Sand</u>	<u>10</u>	<u>95</u>
<u>3</u> miles <u>N</u> of <u>Victoria</u>	<u>White Sand</u>	<u>95</u>	<u>125</u>
WELL PURPOSE: <u>Home</u> (home, irrigation, municipal, industrial)			
WELL COMPLETION DATA:			
(1) diameter (inches) <u>4</u>			
(2) total depth (feet) <u>125</u>			
(3) static water level (feet) <u>65</u> below top of ground.			
(4) casing <u>PVC</u> , <u>125</u> (material) (depth)			
_____ if telescope see back. (size)			
(5) screen <u>7</u> , <u>118</u> (length) (depth to top)			
<u>52</u> , <u>granite</u> (size) (material)			
(6) pump <u>1/2</u> , <u>10</u> (HP) (yield gpm)			
<u>220V</u> (type power)			
(7) electric log <u>No</u> (yes or no)			
_____ (organization running log)			
(8) how well bottom plugged <u>Cap</u>			
DRILLERS REMARKS:			


DEPT. OF NATURAL RESOURCES
BUREAU OF LAND & WATER RESOURCES

DEC 23 1980

RECEIVED

If well telescopes please sketch and show depths.

GROUND LEVEL

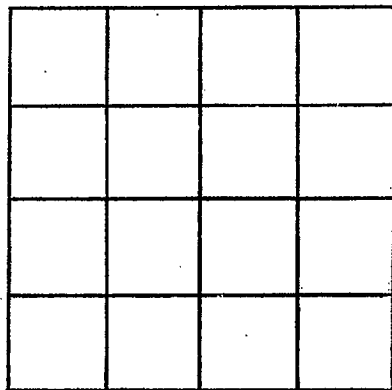

SECTION 82

Please indicate well location X.

ADDITIONAL INFORMATION

If more than one screen, show locations of each on sketch.