

MISSISSIPPI DEPARTMENT OF NATURAL RESOURCES

Bureau of Land and Water Resources

Southport Mall

P.O. Box 10631

Jackson, Mississippi 39209

WATER WELL DRILLERS LOG

MARSHALL  
E 2053  
1-5-81  
1-5

8

date well completed

firm name

county well located

19 81 Hick Well Co. Marshall

LANDOWNER: Linda Roe  
Marsha Farms, Et al  
B. Baker, P.O.  
(mailing address)

description of formations encountered	from	to
<u>Red Clay</u>	<u>0</u>	<u>10</u>
<u>Clay + Sand</u>	<u>10</u>	<u>95</u>
<u>White Sand</u>	<u>95</u>	<u>125</u>

WELL LOCATION:

sec. 27 T. 2 N. R. 4 E. (W)  
3 miles N of Victoria  
 (distance) (direction) (nearest town)

WELL PURPOSE: private  
 (home, irrigation, municipal, industrial)

WELL COMPLETION DATA:

- (1) diameter (inches) 4
- (2) total depth (feet) 125
- (3) static water level (feet) 60 below top of ground.
- (4) casing PVC 125  
 (material) (depth)
- (size) If telescope see back.
- (5) screen 7 18  
 (length) (depth to top)
- 02 granite  
 (size) (material)
- (6) pump 1/2 10  
 (HP) (yield gpm)
- 228V  
 (type power)
- (7) electric log No  
 (yes or no)

(organization running log)

(8) how well bottom plugged Csp

DEPT. OF NATURAL RESOURCES  
 BUREAU OF LAND & WATER RESOURCES


JAN 12 1981

RECEIVED

DRILLERS REMARKS:

If well telescopes please sketch and show depths.

GROUND LEVEL

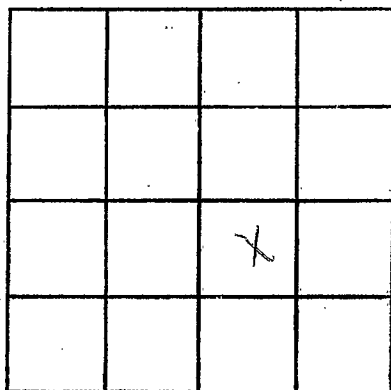

SECTION 27

Please indicate well location X.

ADDITIONAL INFORMATION

If more than one screen, show locations of each on sketch.