

MISSISSIPPI DEPARTMENT OF NATURAL RESOURCES

Bureau of Land and Water Resources

Southport Mall

P.O. Box 10631

Jackson, Mississippi 39209

WATER WELL DRILLERS LOG

MARSHALL
E 2054
2/23/81
2-23-81

date well completed

firm name

county well located

19 Wilson Well Co. For Marshall

LANDOWNER:

Harry Miller
Rt 2

description of formations encountered

from

to

<u>Red Clay - Red Sand</u>	<u>0</u>	<u>30</u>
<u>White clay - White Sand</u>	<u>30</u>	<u>60</u>
<u>White sand</u>	<u>60</u>	<u>90</u>
<u>White sand - White clay</u>	<u>90</u>	<u>105</u>
<u>White sand</u>	<u>105</u>	<u>135</u>

Maunt Pleasant Miss

also 1072 Gettesburg Circle - Collierville

WELL LOCATION:

sec. 36T 2 N R. 4 E 13W

3 miles W of Ma Pleasant
(distance) (direction) (nearest town)

WELL PURPOSE:

frame
(home, irrigation, municipal, industrial)

WELL COMPLETION DATA:

- (1) diameter (inches) 4"
- (2) total depth (feet) 135
- (3) static water level (feet) _____ below
top of ground. above
- (4) casing Plastic, 125
(material) (depth)
4"
(size) if telescope see back.
- (5) screen 10'
(length) (depth to top)
4" Plastic
(size) (material)
- (6) pump 1 15
(HP) (yield gpm)
electric
(type power)
- (7) electric log NO
(yes or no)

(organization running log)

- (8) how well bottom plugged 4" Plastic CAP


DRILLERS REMARKS:

DEPT. OF NATURAL RESOURCES
BUREAU OF LAND & WATER RESOURCES

RECEIVED
MAR - 2 1981

If well telescopes please sketch and show depths.

GROUND LEVEL

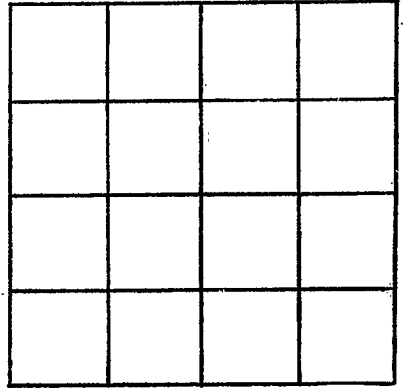

SECTION _____

Please indicate well location X.

ADDITIONAL INFORMATION

If more than one screen,
show locations of each on sketch.