

MISSISSIPPI DEPARTMENT OF NATURAL RESOURCES

Bureau of Land and Water Resources

Southport Mall

P.O. Box 10631

Jackson, Mississippi 39209

WATER WELL DRILLERS LOG

MARSHALL
E 2055
3-13-81

3-13 1981 Hicks Well Co Marshall
date well completed firm name county well located

LANDOWNER: Fred Bell
Rt. 1 Box 449W
Bayou La Batre, Mo.
(mailing address)

description of formations encountered	from	to
	<u>Red sand</u>	<u>0</u>
<u>White sand</u>	<u>35</u>	<u>125</u>

WELL LOCATION:
sec. 34 2 N 4 E
(S) (W)
2 miles N of Vinton
(distance) (direction) (nearest town)

WELL PURPOSE: Home
(home, irrigation, municipal, industrial)

WELL COMPLETION DATA:

(1) diameter (inches) 4

(2) total depth (feet) 125

(3) static water level (feet) 80 below above top of ground.

(4) casing PVC, 125
(material) (depth)

1 If telescope see back.
(size)

(5) screen 7, 113
(length) (depth to top)

4" perforated pipe
(size) (material)

(6) pump 1/2, 10
(HP) (yield gpm)

220V
(type power)

(7) electric log No
(yes or no)

Cap
(organization running log)

(8) how well bottom plugged Cap

DRILLERS REMARKS:


DEPT. OF NATURAL RESOURCES
BUREAU OF LAND & WATER RESOURCES

MAR 18 1981

RECEIVED

If well telescopes please sketch and show depths.

GROUND LEVEL

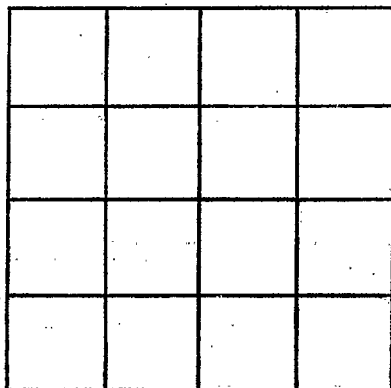

SECTION _____

Please indicate well location X.

ADDITIONAL INFORMATION

If more than one screen, show locations of each on sketch.