

Marshall

E 256

4/17/81

April 19

date well completed

MISSISSIPPI BOARD OF WATER COMMISSIONERS
416 North State Street
Jackson, Mississippi 39201

WATER WELL DRILLERS LOG


1981 Earl Jones Well Co.

firm name

Marshall


county well located

LANDOWNER:	description of formations encountered	from	to
P.C. Brown Byhalia Miss. RT1 (mailing address)	Topsoil & clay sand	0 16	16 40
WELL LOCATION: sec 3 4 T 2 N R 4 E 1 3/4 miles NE of Victoria (distance) (direction) (nearest town)	clay sand clay sand	40 44 125 132	44 135 132 160
WELL PURPOSE: Home (home, irrigation, municipal, industrial)			
WELL COMPLETION DATA:			
(1) diameter (inches) 4"			
(2) total depth (feet) 160			
(3) static water level (feet) 135 below top of ground.			
(4) casing plastic 150 (material) (depth)			
4" if telescope see back. (size)			
(5) screen 10' 150 (length) (depth to top)			
4" - 013 plastic (size) (material)			
(6) pump 1/2 13 (HP) (yield gpm) electric (type power)			
(7) electric log no (yes or no)			
(organization running log)			
(8) how well bottom plugged plastic cap.			
DRILLERS REMARKS:			

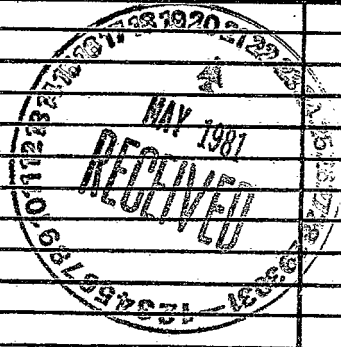

If well telescopes please sketch and show depths.

GROUND LEVEL

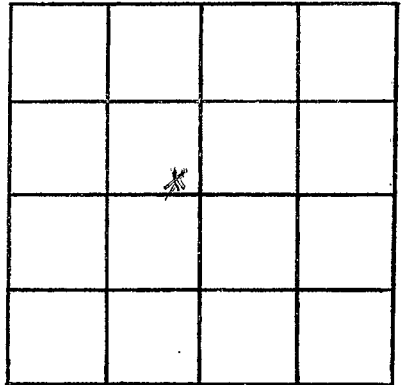

SECTION 34

Please indicate well location X.

ADDITIONAL INFORMATION

If more than one screen,
show locations of each on sketch.