

MISSISSIPPI DEPARTMENT OF NATURAL RESOURCES

Bureau of Land and Water Resources

Southport Mall

P.O. Box 10631


Jackson, Mississippi 39209

WATER WELL DRILLERS LOG

Marshall
E 2058
7-21-81


7-21 19 81 Hicks Well Co. Marshall
date well completed firm name county well located

LANDOWNER:	description of formations encountered	from	to
<u>James Deacon</u> <u>Ret.</u>			
<u>Bayou Vista, MS</u> (mailing address)	<u>Red Clay</u>	<u>0</u>	<u>10</u>
	<u>Red Sand</u>	<u>10</u>	<u>15</u>
	<u>Rock</u>	<u>15</u>	<u>18</u>
	<u>Gravel & Clay</u>	<u>18</u>	<u>65</u>
	<u>White Sand</u>	<u>65</u>	<u>140</u>
WELL LOCATION:			
sec. <u>9</u> T. <u>2</u> N. R. <u>4</u> E. <u>6</u> miles <u>N</u> of <u>Winters</u> (distance) (direction) (nearest town)			
WELL PURPOSE: <u>Home</u> (home, irrigation, municipal, industrial)			
WELL COMPLETION DATA:			
(1) diameter (inches) <u>4</u>			
(2) total depth (feet) <u>140</u>			
(3) static water level (feet) <u>80</u> below above top of ground.			
(4) casing <u>PVC 140</u> (material) (depth)			
(size) If telescope see back.			
(5) screen <u>12</u> <u>128</u> (length) (depth to top)			
<u>4"</u> <u>gravel + PVC</u> (size) (material)			
(6) pump <u>1/2</u> <u>10</u> (HP) (yield gpm)			
<u>220V</u> (type power)			
(7) electric log <u>No</u> (yes or no)			
(organization running log)			
(8) how well bottom plugged <u>Cap</u>			
DRILLERS REMARKS:			

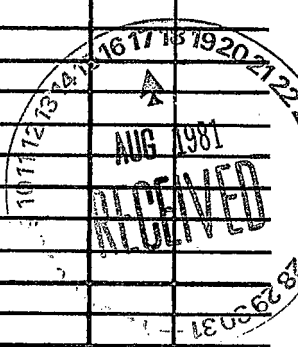

If well telescopes please sketch and show depths.

GROUND LEVEL

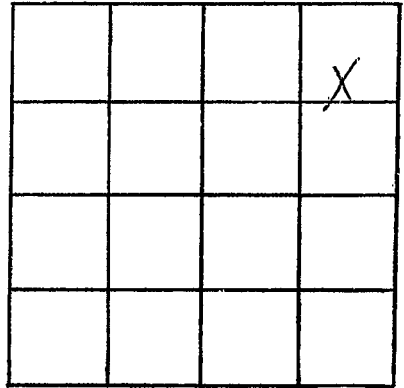

SECTION 9

Please indicate well location X.

ADDITIONAL INFORMATION

If more than one screen,
show locations of each on sketch.