


Marshall  
E 2059  
8-3-81

MISSISSIPPI  
 BOARD OF WATER COMMISSIONERS  
 416 North State Street  
 Jackson, Mississippi 39201

WATER WELL DRILLERS LOG


Aug 3 1981 Erl Jones Well Co. Marshall  
 date well completed firm name county well located

| LANDOWNER:  | description of formations encountered | from       | to         |
|---|---------------------------------------|------------|------------|
| <u>Jackie Nichols</u><br><u>Byholia Miss. Rt.</u><br>(mailing address)  | <u>Topsail + clay</u>                 | <u>0</u>   | <u>18</u>  |
|   | <u>sand</u>                           | <u>18</u>  | <u>65</u>  |
|   | <u>clay</u>                           | <u>65</u>  | <u>70</u>  |
| WELL LOCATION:<br>sec <u>34</u> T <u>2</u> N R <u>4</u> E<br><u>1 3/4</u> miles <u>NE</u> of <u>Victoria</u><br>(distance) (direction) (nearest town) | <u>sand</u>                           | <u>70</u>  | <u>78</u>  |
|   | <u>clay</u>                           | <u>78</u>  | <u>84</u>  |
|   | <u>sand</u>                           | <u>84</u>  | <u>110</u> |
|   | <u>clay</u>                           | <u>110</u> | <u>125</u> |
|   | <u>sand</u>                           | <u>125</u> | <u>165</u> |
| WELL PURPOSE: <u>Home</u><br>(home, irrigation, municipal, industrial)  |                                       |            |            |
| WELL COMPLETION DATA:   |                                       |            |            |
| (1) diameter (inches) <u>4"</u>   |                                       |            |            |
| (2) total depth (feet) <u>165</u>   |                                       |            |            |
| (3) static water level (feet) <u>122</u> below<br>top of ground.  |                                       |            |            |
| (4) casing <u>plastic</u> <u>155</u><br>(material) (depth)  |                                       |            |            |
| <u>4"</u><br>(size) if telescope see back.  |                                       |            |            |
| (5) screen <u>10'</u> <u>155</u><br>(length) (depth to top)   |                                       |            |            |
| <u>013-4"</u> <u>plastic</u><br>(size) (material)   |                                       |            |            |
| (6) pump <u>3/4</u> <u>14</u><br>(HP) (yield gpm)<br><u>electric</u><br>(type power)  |                                       |            |            |
| (7) electric log <u>no</u><br>(yes or no)   |                                       |            |            |
| (organization running log)  |                                       |            |            |
| (8) how well bottom plugged<br><u>plastic cap</u>   |                                       |            |            |
| DRILLERS REMARKS:   |                                       |            |            |

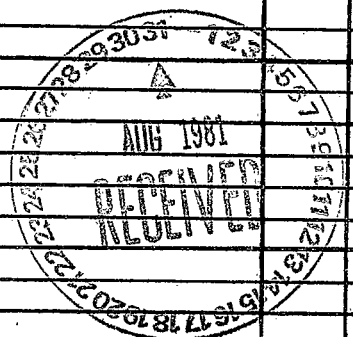

If well telescopes please sketch and show depths.

GROUND LEVEL

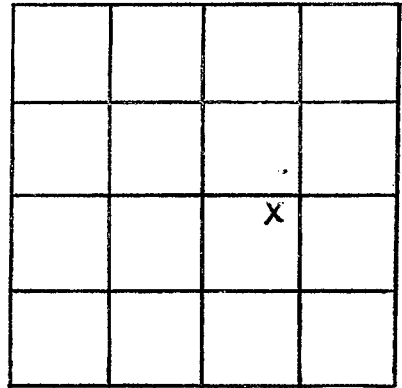

SECTION 34

Please indicate well location X.

ADDITIONAL INFORMATION

If more than one screen,  
show locations of each on sketch.