


Marshall
E 2060
8-6-81

MISSISSIPPI
 BOARD OF WATER COMMISSIONERS
 416 North State Street
 Jackson, Mississippi 39201

WATER WELL DRILLERS LOG

Aug 6 1981 Earl Jones Well Co Marshall
 date well completed firm name county well located

LANDOWNER:	description of formations encountered	from	to
<u>C.R. Pittman</u>			
<u>Richard Victoria Miss. PO Box</u> (mailing address)	<u>Topsoil & clay</u>	<u>0</u>	<u>20</u>
	<u>sand</u>	<u>20</u>	<u>40</u>
	<u>clay</u>	<u>40</u>	<u>44</u>
	<u>sand</u>	<u>44</u>	<u>85</u>
	<u>clay</u>	<u>85</u>	<u>92</u>
	<u>sand</u>	<u>92</u>	<u>110</u>
	<u>clay</u>	<u>110</u>	<u>114</u>
	<u>sand</u>	<u>114</u>	<u>165</u>
WELL LOCATION: sec <u>34</u> T <u>2</u> N R <u>4</u> E <u>1 3/4</u> miles <u>NE</u> of <u>Victoria</u> (distance) (direction) (nearest town)			
WELL PURPOSE: <u>Home</u> (home, irrigation, municipal, industrial)			
WELL COMPLETION DATA:			
(1) diameter (inches) <u>4"</u>			
(2) total depth (feet) <u>165</u>			
(3) static water level (feet) <u>123</u> below top of ground.			
(4) casing <u>plastic</u> , <u>155</u> (material) (depth)			
<u>4"</u> (size) if telescope see back.			
(5) screen <u>10'</u> , <u>155</u> (length) (depth to top)			
<u>013-4"</u> , <u>plastic</u> (size) (material)			
(6) pump <u>3/4</u> , <u>14</u> (HP) (yield gpm)			
<u>electric</u> (type power)			
(7) electric log <u>no</u> (yes or no)			
(organization running log)			
(8) how well bottom plugged <u>plastic cap</u>			
DRILLERS REMARKS:			

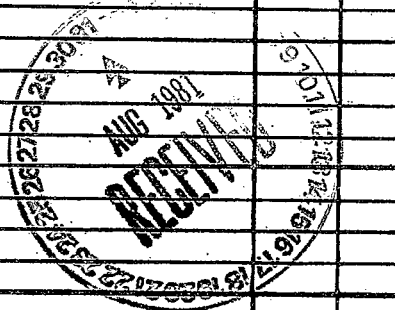

If well telescopes please sketch and show depths.

GROUND LEVEL

	X		

SECTION 3

Please indicate well location X.

ADDITIONAL INFORMATION

If more than one screen, show locations of each on sketch.

