

MISSISSIPPI DEPARTMENT OF NATURAL RESOURCES

Bureau of Land and Water Resources

Southport Mall

P.O. Box 10631

Jackson, Mississippi 39209

WATER WELL DRILLERS LOG

MARSHALL
 E 2061
 8-12-81

8-12-81 19 Wilson Well Co Marshall
 date well completed firm name county well located

LANDOWNER:
JAMES C. DREW
3800 DOUGLASS
Memphis TN
 (mailing address)

| description of formations encountered | from | to |
|---------------------------------------|------|-----|
| Red clay - Red Sand | 0 | 30 |
| White clay | 30 | 60 |
| White clay - White sand | 60 | 90 |
| White SAND | 90 | 150 |

WELL LOCATION:
 sec. 25 T 2 N R 4 E
3 miles N of Victorians
 (distance) (direction) (nearest town)

WELL PURPOSE: Home
 (home, irrigation, municipal, industrial)

WELL COMPLETION DATA:
 (1) diameter (inches) 4
 (2) total depth (feet) 145
 (3) static water level (feet) 95 below top of ground.
 (4) casing Plastic (material) (depth)
4 if telescope see back. (size)
 (5) screen 40' (length) (depth to top)
40 (size) Plastic (material)
 (6) pump 3/4 (HP) 8 (yield gpm)
electric (type power)
 (7) electric log No (yes or no)

(organization running log)
 (8) how well bottom plugged Plastic Cap 4"

DRILLERS REMARKS:


DEPT. OF NATURAL RESOURCES
 BUREAU OF LAND & WATER RESOURCES

AUG 25 1981

RECEIVED

If well telescopes please sketch and show depths.

GROUND LEVEL

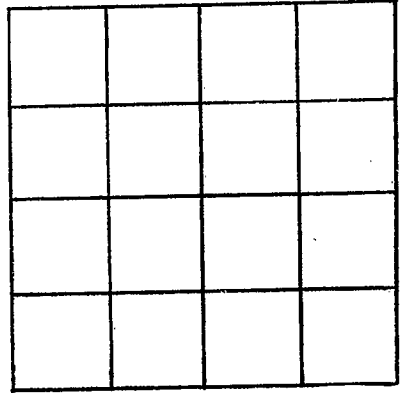

SECTION _____

Please indicate well location X.

ADDITIONAL INFORMATION



If more than one screen, show locations of each on sketch.