

MISSISSIPPI DEPARTMENT OF NATURAL RESOURCES

Bureau of Land and Water Resources

Southport Mall

P.O. Box 10631

Jackson, Mississippi 39209

WATER WELL DRILLERS LOG

Marshall
E 262
8-12-81

8-12-81 19
 date well completed

Wilson Well Co
 firm name

Marshall
 county well located

LANDOWNER:
Mike Maynor
Rt 3 Box 459 A
Byhalia Miss
 (mailing address) 38611

description of formations encountered	from	to
<u>Red clay - Red Sand</u>	<u>0</u>	<u>30</u>
<u>White clay</u>	<u>30</u>	<u>60</u>
<u>White clay - White Sand</u>	<u>60</u>	<u>90</u>
<u>White Sand</u>	<u>90</u>	<u>120</u>
<u>White Sand - White clay</u>	<u>120</u>	<u>150</u>

WELL LOCATION:
 sec 28 T 2 N R 4 E
3 miles (distance) N (direction) of Victorville (nearest town)

WELL PURPOSE: Home
 (home, irrigation, municipal, industrial)

WELL COMPLETION DATA:

(1) diameter (inches) 4

(2) total depth (feet) 137

(3) static water level (feet) 100 below top of ground.

(4) casing PLASTIC (material) (depth) 4 (size) If telescope see back.

(5) screen 10' (length) (depth to top) 4" (size) PLASTIC (material)

(6) pump 1 (HP) 14 (yield gpm) electric (type power)

(7) electric log NO (yes or no)

(8) how well bottom plugged 4" (organization running log)

DRILLERS REMARKS:


DEPT. OF NATURAL RESOURCES
 BUREAU OF LAND & WATER RESOURCES

AUG 25 1981

RECEIVED

If well telescopes please sketch and show depths.

GROUND LEVEL

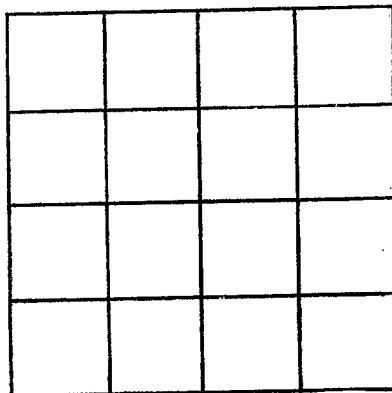

SECTION _____

Please indicate well location X.

ADDITIONAL INFORMATION



If more than one screen, show locations of each on sketch.