

MISSISSIPPI DEPARTMENT OF NATURAL RESOURCES

Bureau of Land and Water Resources

Southport Mall

P.O. Box 10631

Jackson, Mississippi 39209

WATER WELL DRILLERS LOG

4

Marshall
E 263
8-13-81

8-13-81 19 Wilson Well Co Marshall
 date well completed firm name county well located

LANDOWNER:	description of formations encountered	from	to
<u>Ed Tourge #</u> <u>Box 186</u> <u>Victoria Ms</u> (mailing address) <u>38679</u>	<u>Red clay - Red Sand - White SAND</u> <u>White Sand</u>	<u>0</u>	<u>30</u> <u>30</u> <u>105</u>

WELL LOCATION:
 sec 28 T 2 N R 4 E
3 miles N of Victoria Ms
 (distance) (direction) (nearest town)

WELL PURPOSE: Home
 (home, irrigation, municipal, industrial)

- WELL COMPLETION DATA:
- (1) diameter (inches) 4
 - (2) total depth (feet) 105
 - (3) static water level (feet) 98 below above top of ground.
 - (4) casing Plastic
 (material) (depth)
4 if telescope see back.
 (size)
 - (5) screen 10'
 (length) (depth to top)
4 Plastic
 (size) (material)
 - (6) pump 3/4 9
 (HP) (yield gpm)
electric
 (type power)
 - (7) electric log no
 (yes or no)
 (organization running log)
 - (8) how well bottom plugged Plastic Cap

DRILLERS REMARKS:


DEPT. OF NATURAL RESOURCES
 BUREAU OF LAND & WATER RESOURCES

AUG 25 1981

RECEIVED

If well telescopes please sketch and show depths.


GROUND LEVEL

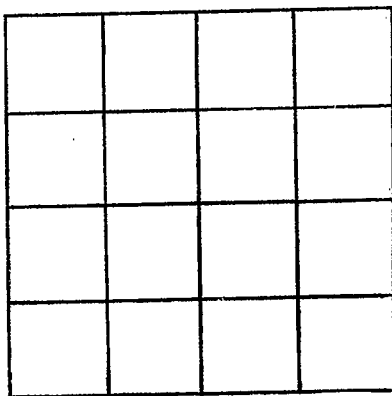

SECTION _____

Please indicate well location X.

ADDITIONAL INFORMATION

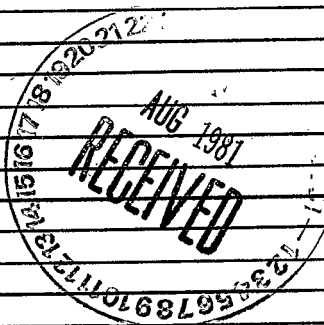

If more than one screen, show locations of each on sketch.