

Marshall
E 2064
8-26-81


MISSISSIPPI
BOARD OF WATER COMMISSIONERS
416 North State Street
Jackson, Mississippi 39201

4

WATER WELL DRILLERS LOG

Aug 26 1981 Earl Jones Well Co. Marshall
date well completed firm name county well located

LANDOWNER:	description of formations encountered	from	to
Sandy Parker Jr. Red Bonds Miss Rt 1 (mailing address)			
WELL LOCATION: sec 26 T 2 N R 4 E S W 2 1/2 miles NE of Victoria (distance) (direction) (nearest town)			
WELL PURPOSE: Home (home, irrigation, municipal, industrial)			
WELL COMPLETION DATA:			
(1) diameter (inches) 4"			
(2) total depth (feet) 185			
(3) static water level (feet) 84 below top of ground.			
(4) casing plastic 175 (material) (depth) 4' (size) if telescope see back.			
(5) screen 10' 175 (length) (depth to top) 0 1/3 - 4" plastic (size) (material)			
(6) pump 1/2 12 (HP) (yield gpm) electric (type power)			
(7) electric log no (yes or no)			
(organization running log)			
(8) how well bottom plugged plastic cap			
DRILLERS REMARKS:			

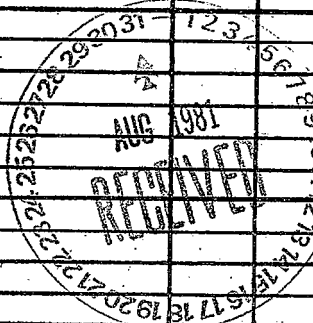

If well telescopes please sketch and show depths.

GROUND LEVEL

X			

SECTION 26

Please indicate well location X.

ADDITIONAL INFORMATION

If more than one screen, show locations of each on sketch.